


T. 39 S., R. 4 W., W. M.

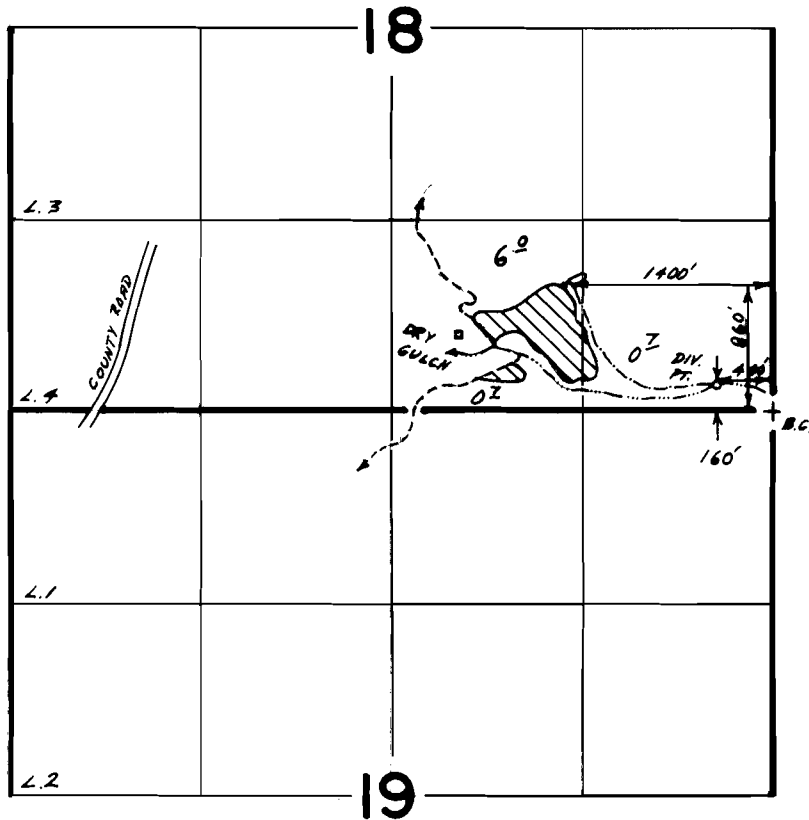

Scale : 1" = 1320'

FINAL PROOF SURVEY
UNDER

R-56986 R-7028

Application No. 56987 Permit No. 42895.....

IN NAME OF

..... B. N. & or LORETTA LANDRUM

Surveyed MAY 26 1982, by B. R. SUND.....