


T. 37S., R. 1E., W. M.

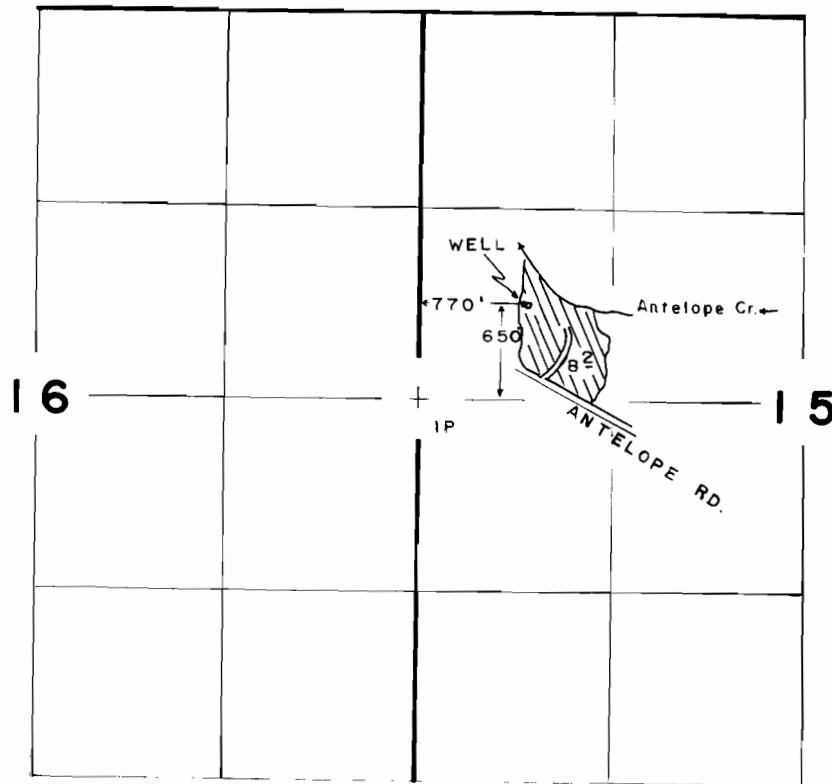

SCALE : 4" = 1 MILE

FINAL PROOF SURVEY UNDER

Application No. G 8673 Permit No. G 8005
IN NAME OF

MORRIS C. &/or FAY M. RISINGER

Surveyed OCT. 1, 1985, by B. S. JAMES.