


T. 34 S., R. 1 W., W. M.
SEC. 16

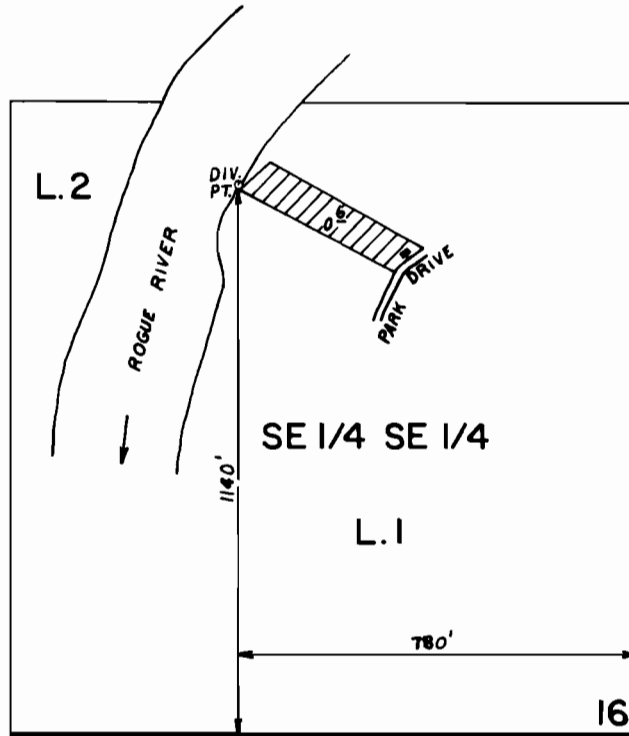

SCALE: 1" = 400'

FINAL PROOF SURVEY
UNDER

Application No. **60315** Permit No. **45677**
IN NAME OF

JAMES E. SHEARER

Surveyed **JUNE 24 1983**, by **B. S. JAMES**