


T. 38S., R. 4W., W.M.

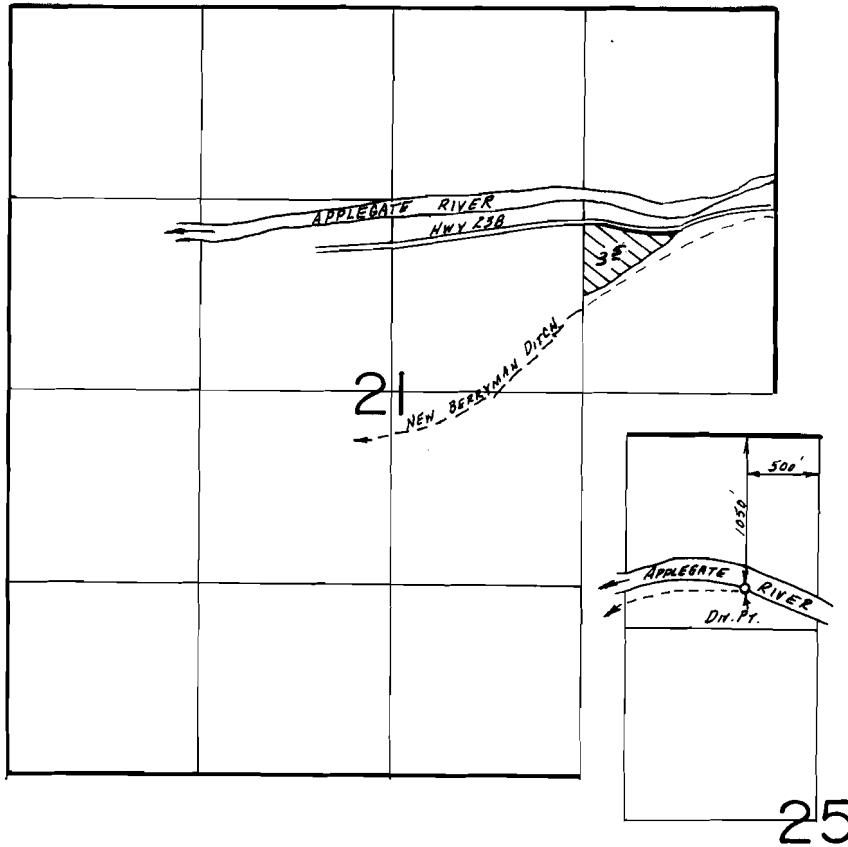

SCALE: 1"=1320'

FINAL PROOF SURVEY
UNDER

Application No. 62260.. Permit No. 46085.....
IN NAME OF

.....ROBERT EARL MARTINDALE.....

Surveyed Aug. 8... 1985, by B.S. JAMES.....