T. 39S., R. 2 E., W.M.

Sec. 32

SE 1/4 SW 1/4

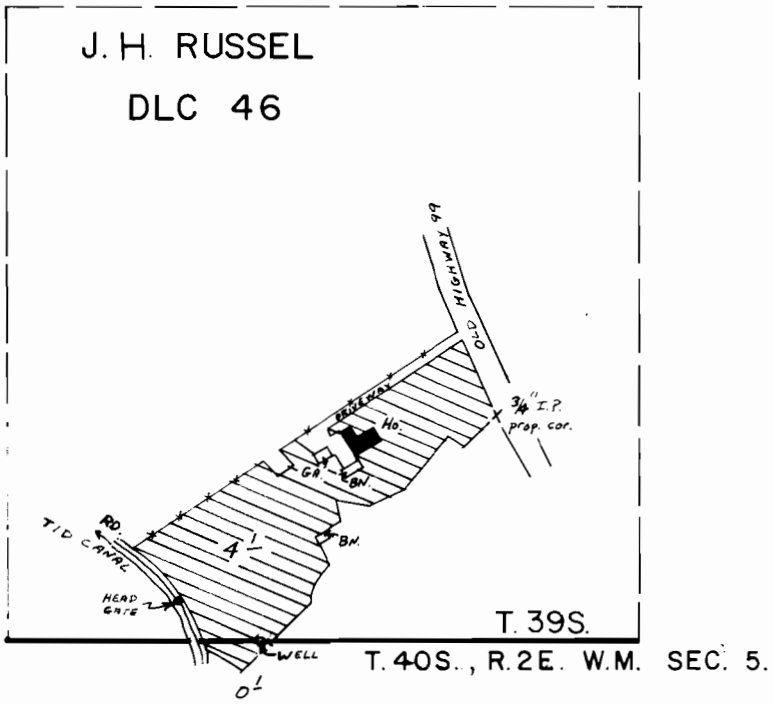

WELL : 0' South & 790' West from the S 1/4 cor. of Sec. 32.

Scale: 1" = 400'

FINAL PROOF SURVEY

UNDER

Application No. G-8206 Permit No. G-7659

IN NAME OF

DANIEL Z. AND MARGARET W. BOYD

Surveyed Aug. 4, 1981, by Bruce R. Sund

PTS-1981-148 by