


R-7733
55761

T.39S.,R.7W.,W.M.

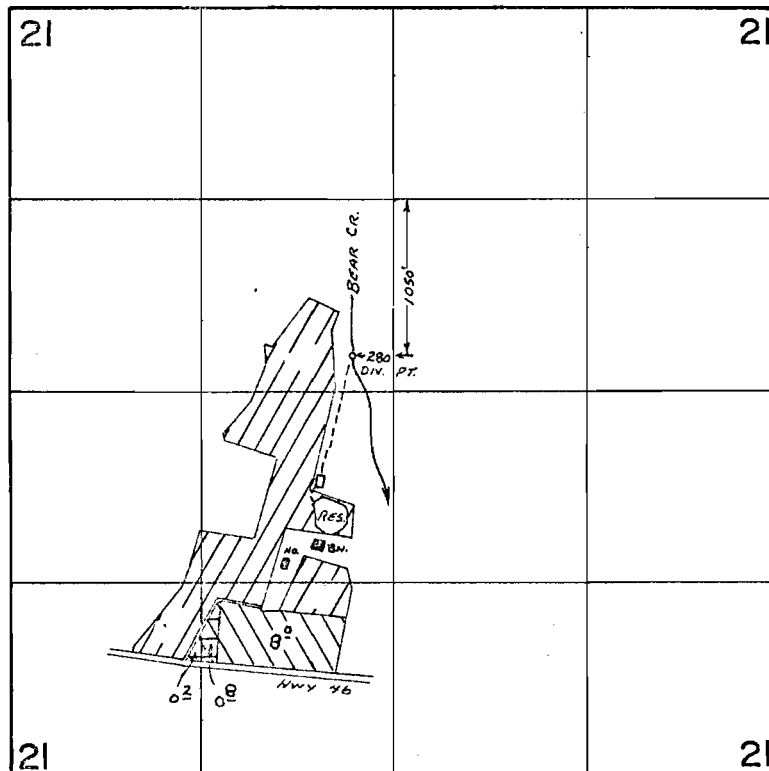

-  - PRIORITY 1857 ,
-  - PRIORITY 1855 ,
-  - PRIORITY 1855 OUT, 1857 IN , TRANS. 3101

Application No. R 52223
Permit No. R 7733