


TWP 39 S R 5 W W M

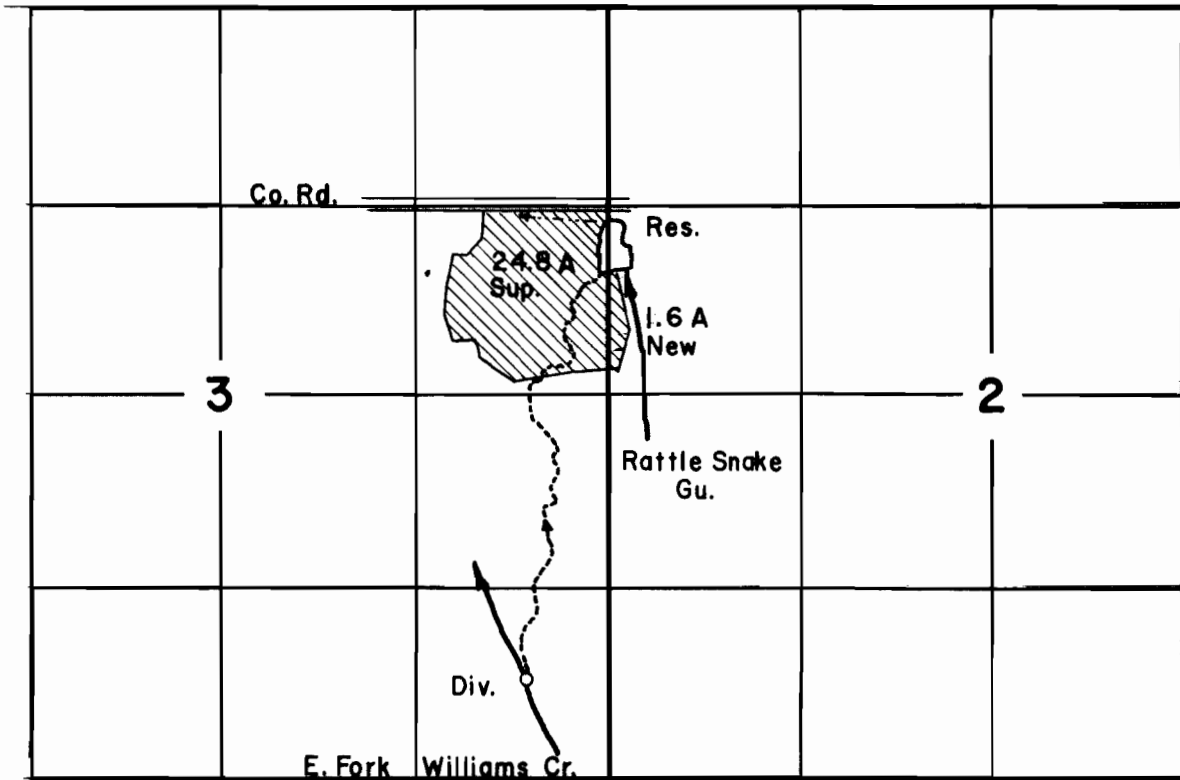

**FINAL PROOF SURVEY**  
UNDER

R-31168 R-1954  
Application No. 31169 Permit No. 24564.  
IN NAME OF

.....Loy & Lena Yokum.....

Surveyed 11-8..... 1961., by Steimer.....