


T.39S., R.8W., W.M.

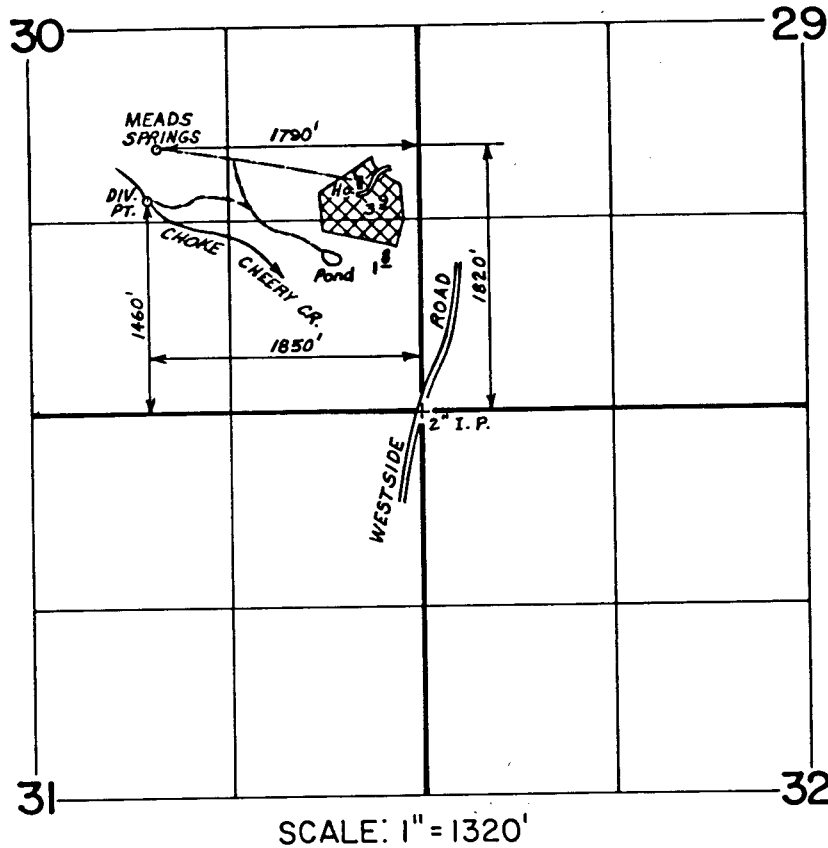

RECEIVED

1987

FILED DIST. 14
179-234L

☒ PRIMARY IRRIGATION from CHOKE CHERRY CREEK

☒ SUPPLEMENTAL IRRIGATION from MEADS SPRINGS

FINAL PROOF SURVEY UNDER

43561 32577
44820 33523
Application No. 58647 Permit No. 44363
IN NAME OF

RICHARD F. MEADS

Surveyed MAY 1 1980, by BRUCE R. SUND
AUG. 24 82 BRUCE R. SUND