


T.39S., R.8W., W.M.

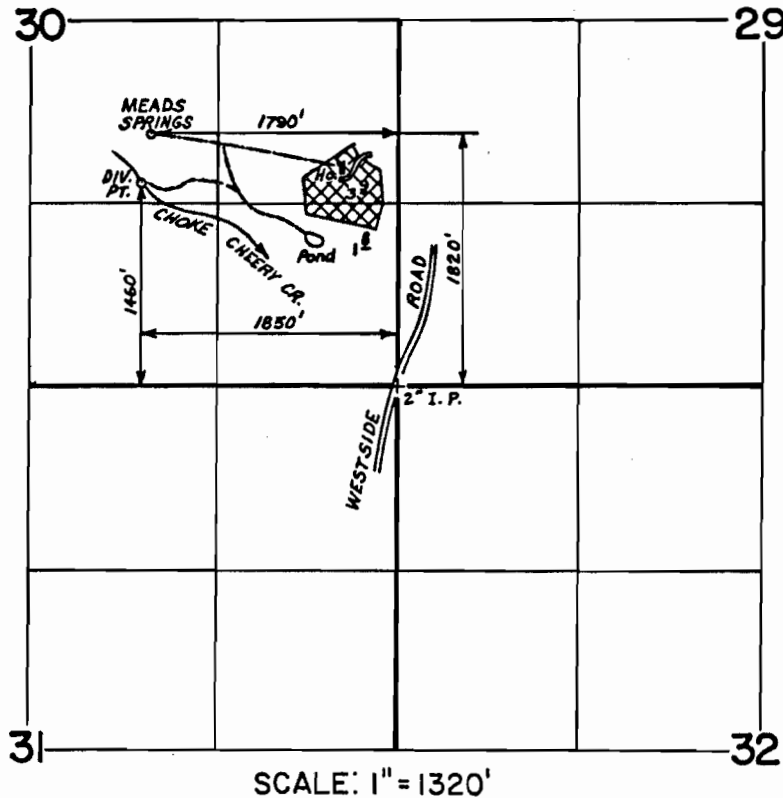

RECEIVED

MAR 20 1987

W.M. DIST. 14
GRANTS PASS, OREG.

- ☒ PRIMARY IRRIGATION from CHOKE CHERRY CREEK
☒ SUPPLEMENTAL IRRIGATION from MEADS SPRINGS

FINAL PROOF SURVEY
UNDER

43561 32577
44820 33523
Application No. 58647 Permit No. 44363
IN NAME OF

.....RICHARD.....F.....MEADS.....

Surveyed MAY 1 1980, by BRUCE R. SUND
AUG. 24 82 BRUCE R. SUND