


T.39S., R.8W., W.M.

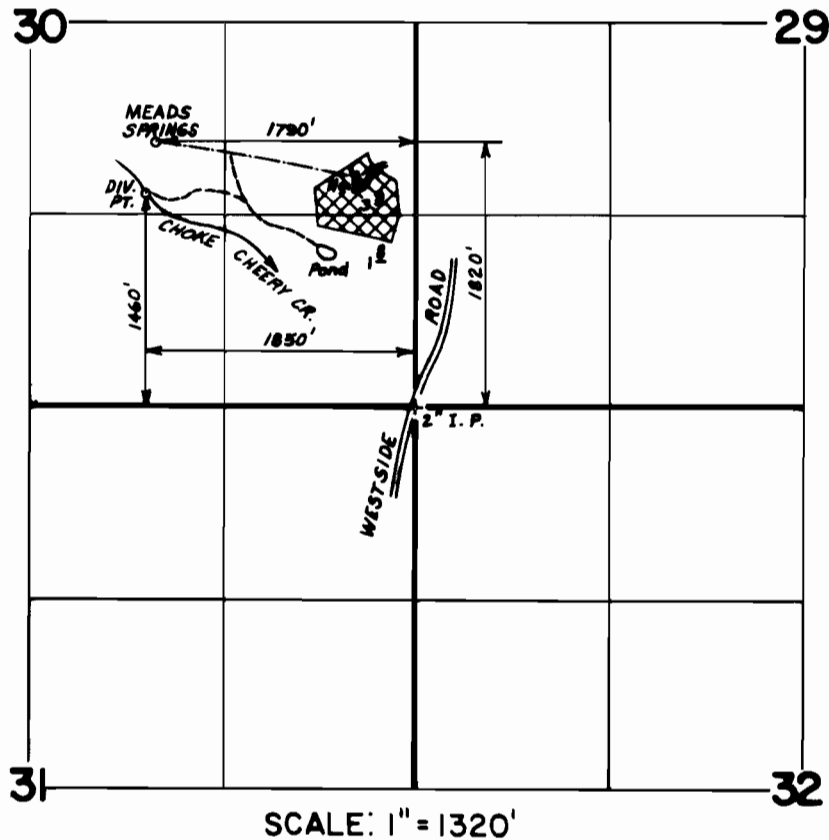

- ☒ PRIMARY IRRIGATION from CHOKO CHERRY CREEK
- ☒ SUPPLEMENTAL IRRIGATION from MEADS SPRINGS

FINAL PROOF SURVEY

UNDER

Application No. **43561** **32577**
44820 **33523**
58647 Permit No. **44363**
IN NAME OF

RICHARD F. MEADS

Surveyed **MAY 1** 19**80**, by **BRUCE R. SUND**
AUG. 24 **82** **BRUCE R. SUND**