


T. 37 S., R. 6 W., W.M.

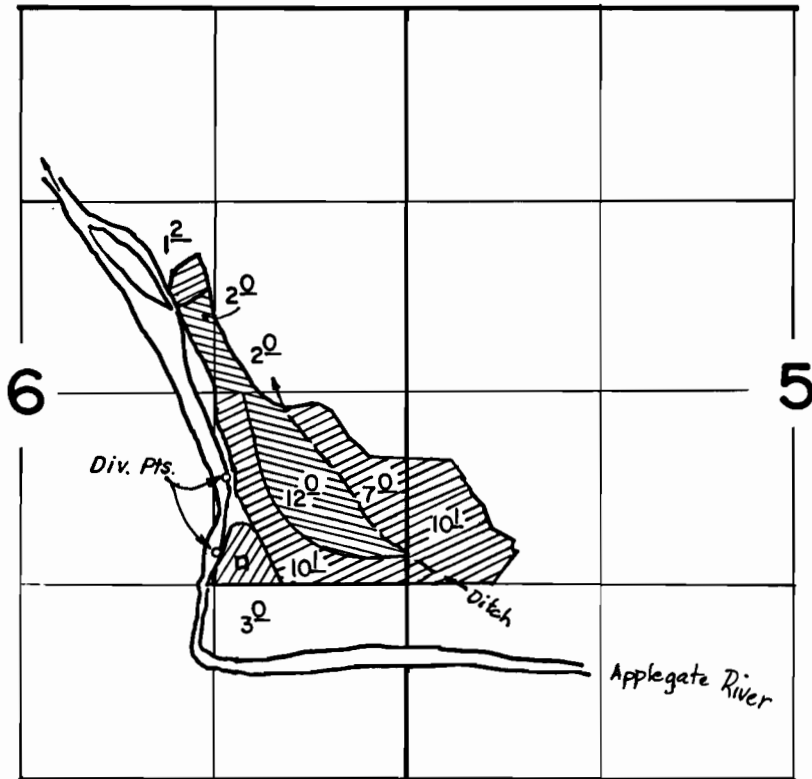

N'LY Div. Pt. located 2060' N. & 1220' W.
 S'LY Div. Pt. located 1550' N. & 1300' W.
 Both from S.E. Corner Section 6.

FINAL PROOF SURVEY UNDER

62127 47296
 TRANSFER NO. 4249
 59186 44434
 Application No. 58883 Permit No. 44429



IN NAME OF

SUZANNE K. POETT

Surveyed AUG. 11, 1982, by B. S. JAMES
 " MAY 5, 1983 " "