T. 37 S., R. 6 W., W.M.

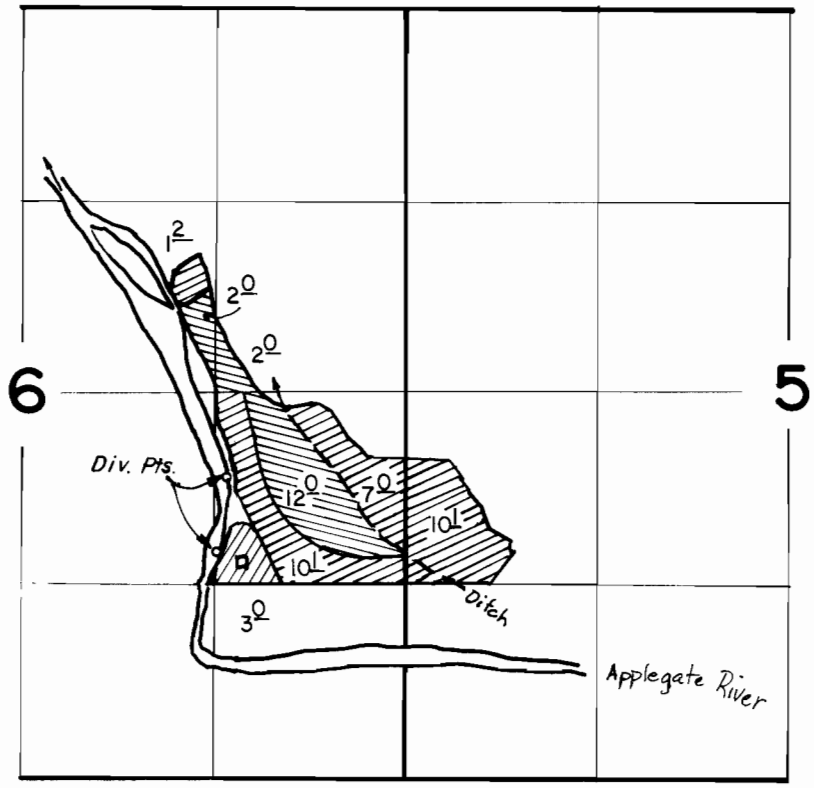

N'LY Div. Pt. located 2060' N. & 1220' W.
S'LY Div. Pt. located 1550' N. & 1300' W.
Both from S.E. Corner Section 6.

FINAL PROOF SURVEY

UNDER

TRANSFER NO. 4249 (62127, 47296)

Application No. 58883 (59186) Permit No. 44429 (44434)

IN NAME OF

SUZANNE K. POETT

Surveyed AUG. 11, 1982, by B. S. JAMES
" MAY 5, 1983 "

B50-3-11 mc 2/84