


**T. 37S. R. 5W. W.M.**

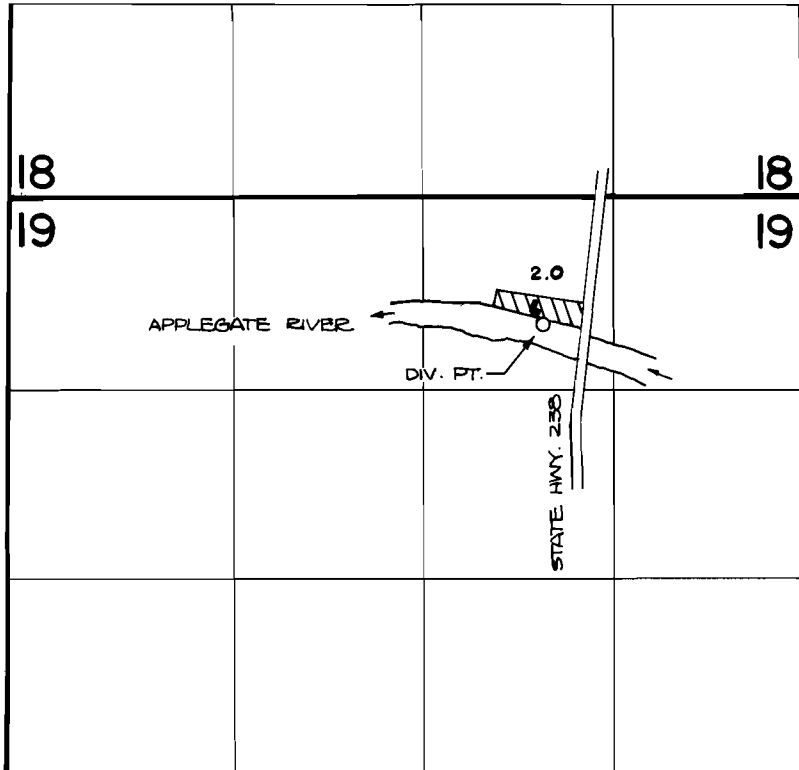

DIVERSION POINT IS LOCATED 800'S. AND 900'E. FROM THE N. 1/4 CORNER OF SECTION 19.

**FINAL PROOF SURVEY**  
UNDER

Application No. **62367** Permit No. **46090**  
IN NAME OF

**LOLA M. CLOSE**

Surveyed **MAY 14** 19**82**, by **B. SUND**