

40742
55781


EVERETT L. MINER

2241 GREENSPRINGS DR.
SPACE 78
KLAMATH FALLS, ORE. 97601

SCALE 8" = 1 MILE

T 34 S R 7 E

Spring Ck. ! mod.

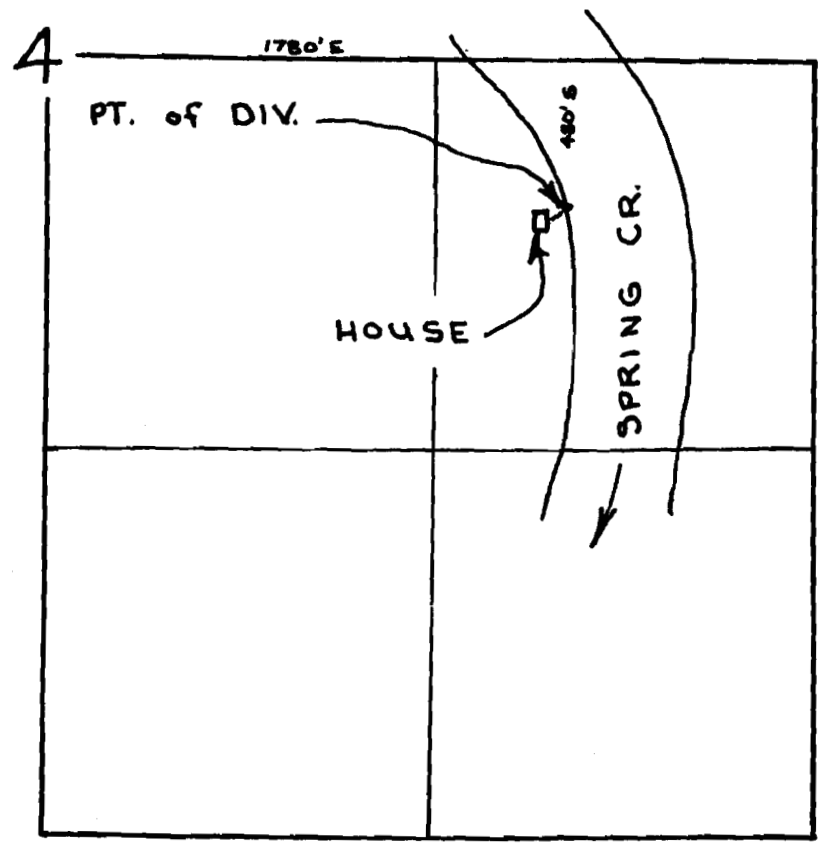

Application No. 54348
Permit No. 40742

RECEIVED

JUN - 8 1976
WATER RESOURCES DEPT
SALEM, OREGON