


42129
55784
Application No. 56315
Permit No. 42129

James H Thomas
349 North Main St.
Ashland, Oregon 97520

T37S R5E
NW NW sec. 14
scale 1"/100'

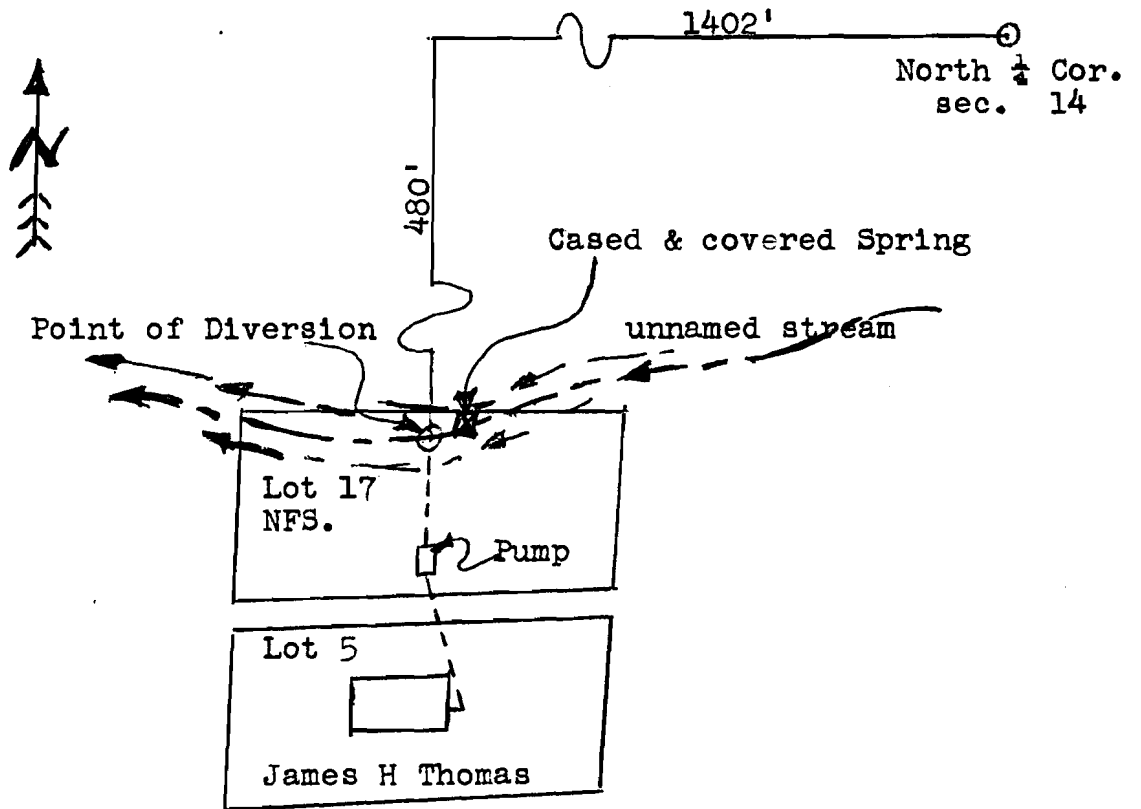

Summer use & more.

Block "W"
East Side Summer Homes
Lake of the Woods