


Journale Co. Misc.

Sec. 10 Sec. 13

Sec. 13 Sec. 10

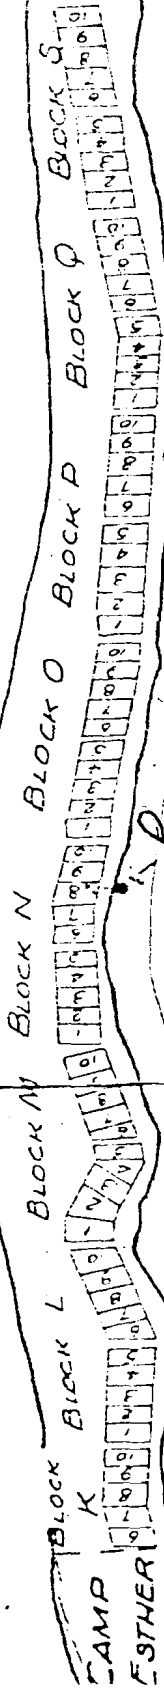

CAMP ESTHER
 MAPLEGATE
 CAMP FIRE GIRLS
 AMERICA

Point of Diversion

939' N. and 1115' E. of the S.W. Corner of ~~Section 10~~
 of Sec. 10, T. 37S., R. 5E., W.M.

RECEIVED


AUG 21 1978

WATER RESOURCES DEPT.
 SALEM, OREGON

LAKE OF THE WOODS

Application No. 57829
 Permit No. 43535

LAKE OF THE W.
 RESOR.
 WHITE PINE
 PICNIC AREA

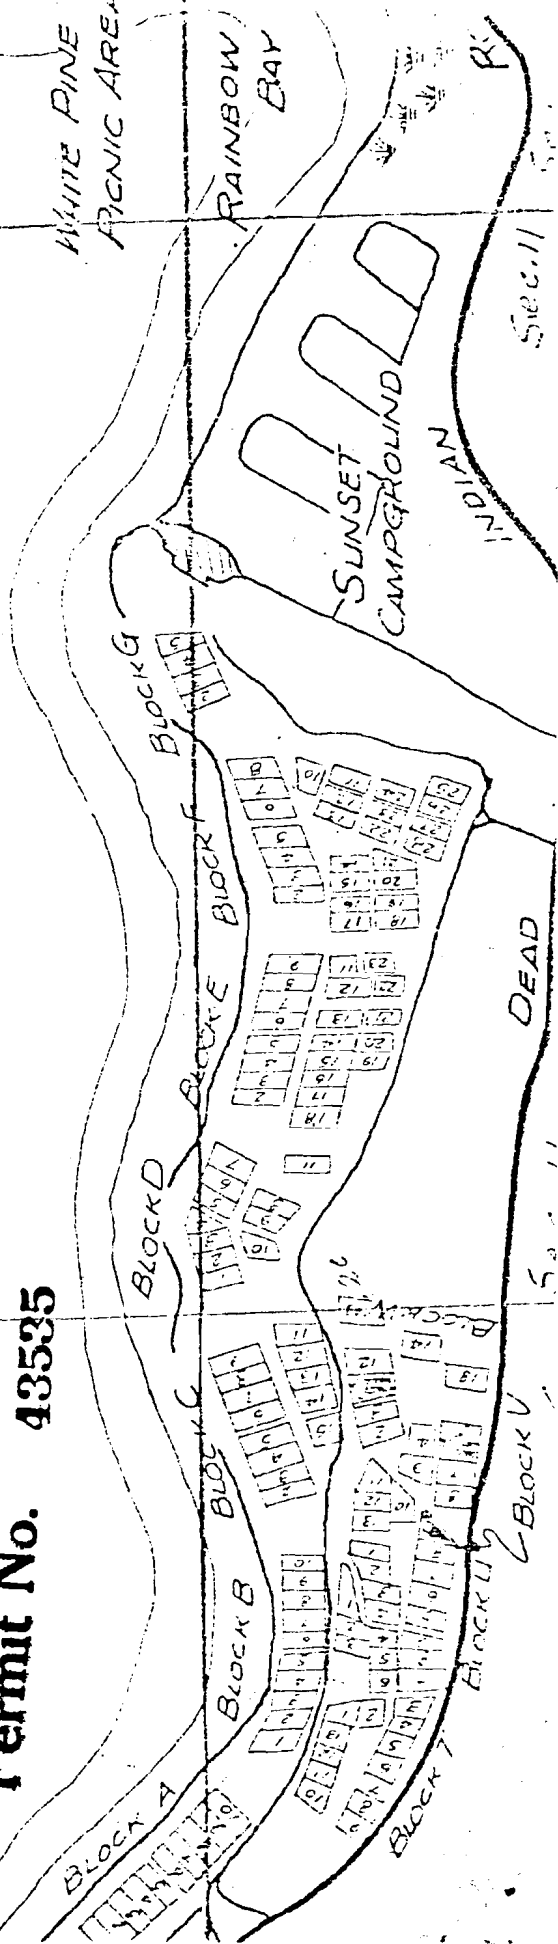

43535
 55787

DEAD

Sec. 11

Block U

Block V