


44161
55788

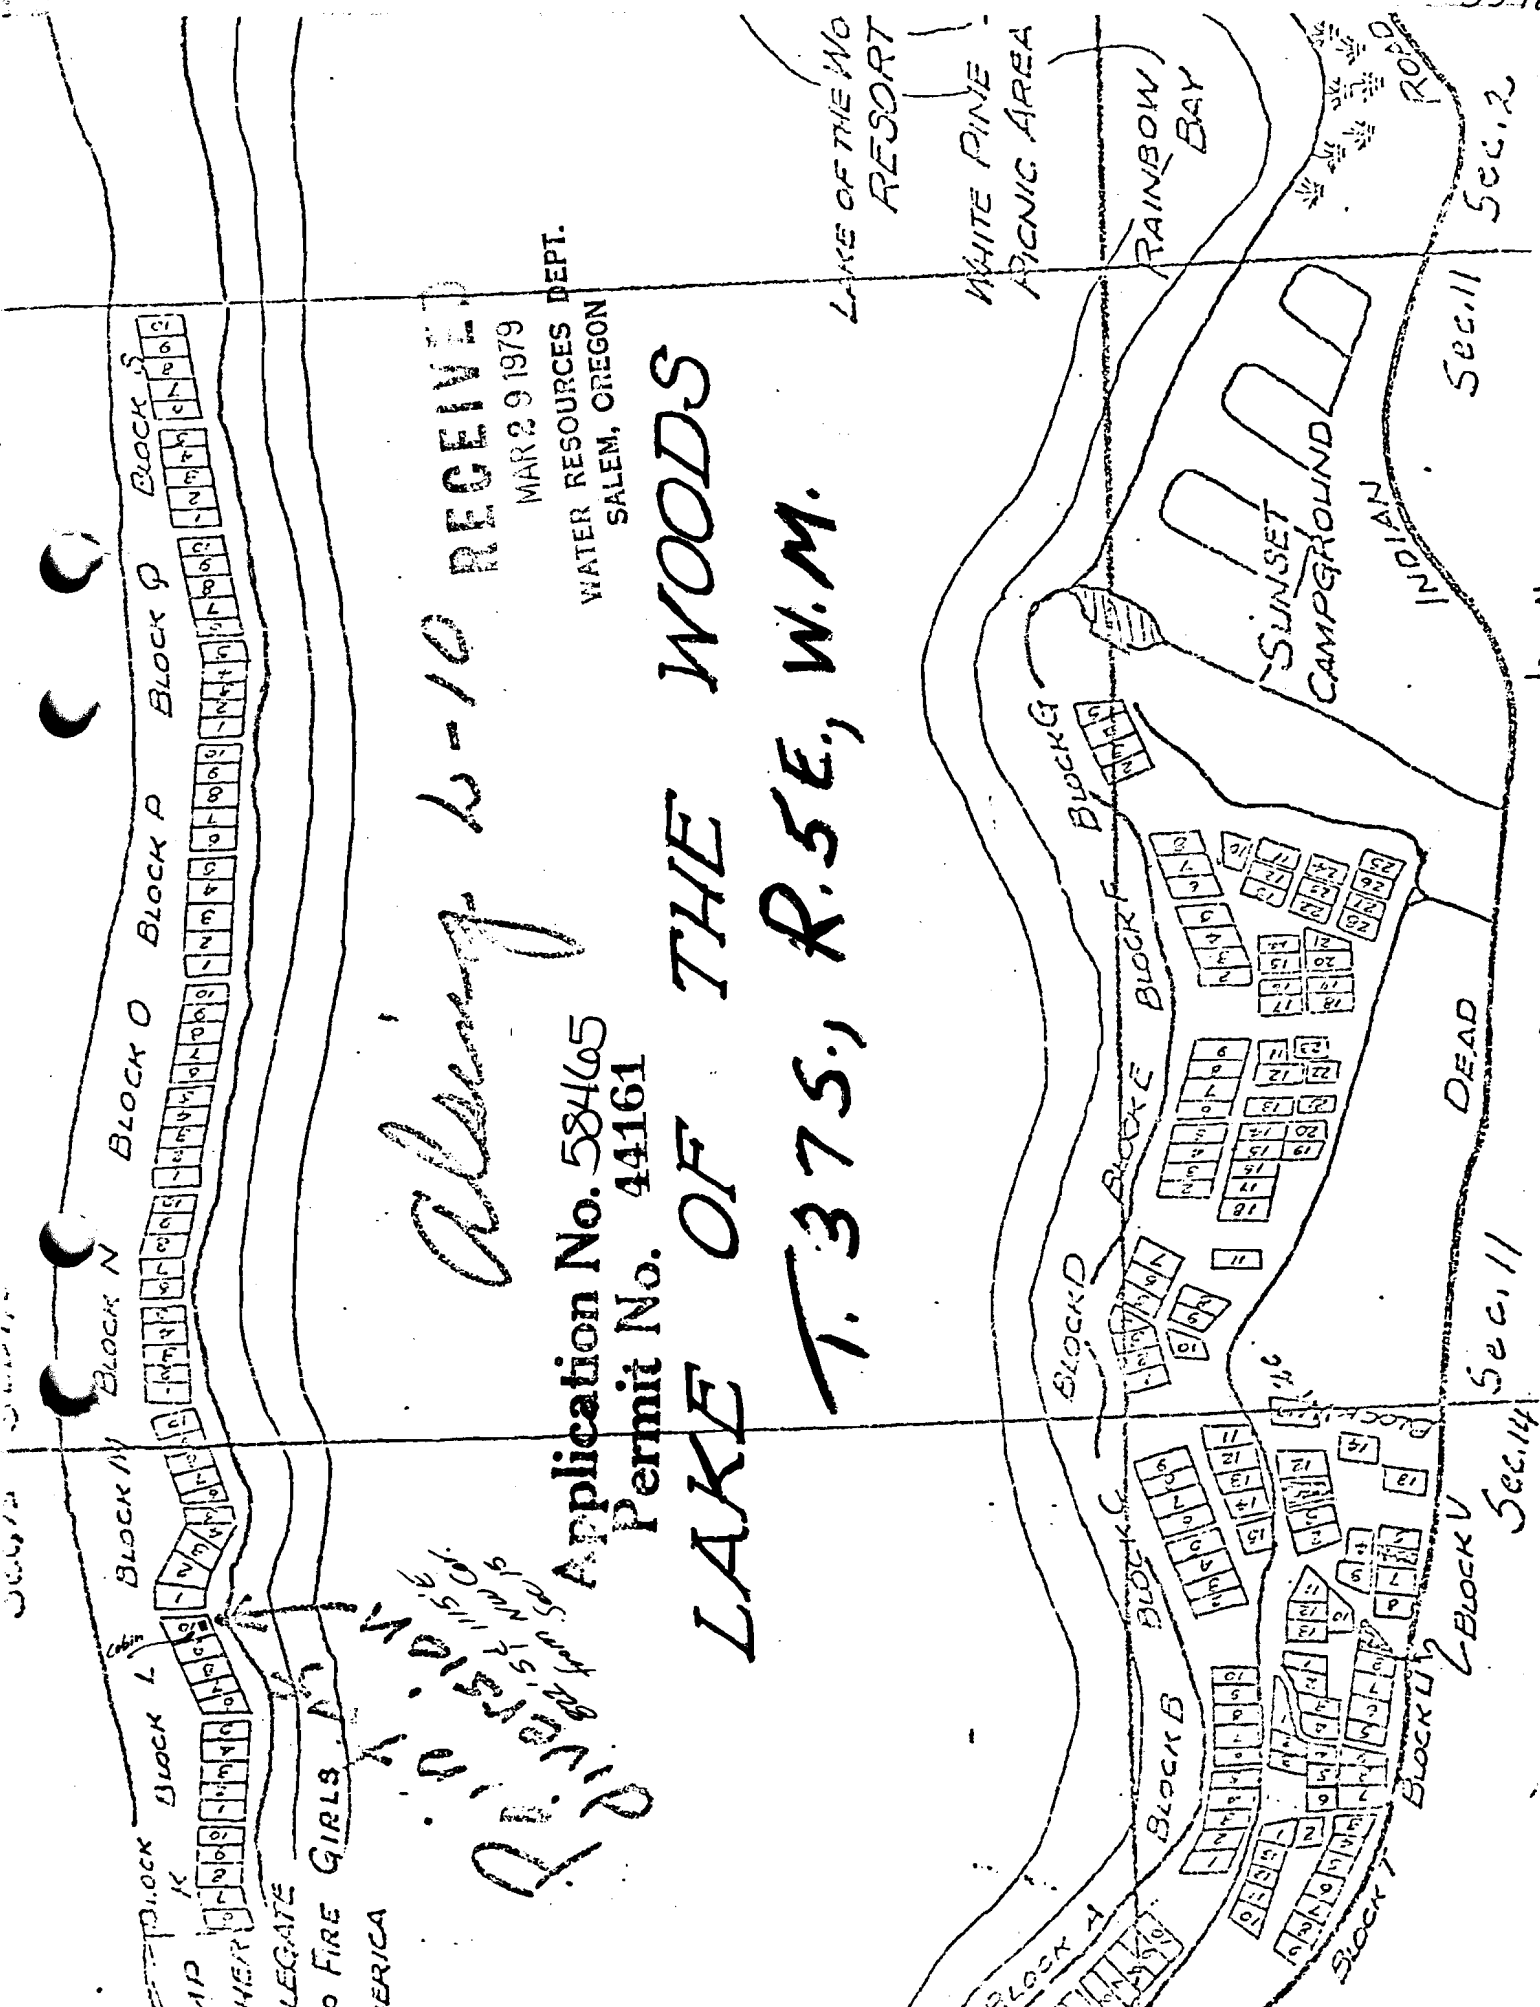

Adm 6-10 RECEIVED
 MAR 29 1979
 WATER RESOURCES DEPT.
 SALEM, OREGON

Application No. 58465
Permit No. 44161

LAKE OF THE WOODS

T. 37 S., R. 5 E., W. 1 M.

RECEIVED
APR 15 1979
WATER RESOURCES DEPT.
SALEM, OREGON

N
 SCALE: 3" = 1 mi

Southwest of ...