


Summer h. misc
SEC. 15 SEC. 10
OFC LAND

SEC. 10 SEC. 3
OFC LAND

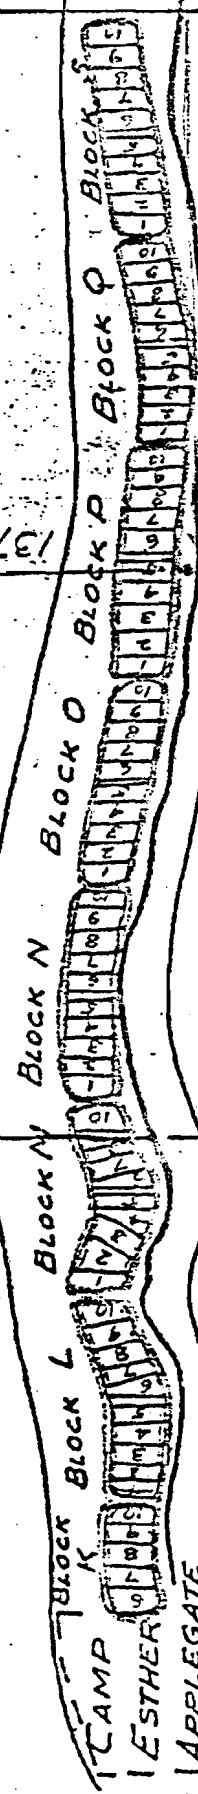

CAMP ESTHER
APPLEGATE
CAMP FIRE GIRLS
OF AMERICA


RECEIVED
APR 28 1979
WATER RESOURCES DEPT.
SALEM, OREGON

Point of Deed
137' E + 2552' S
R5E, W44W
POINT OF DEED, LOT 15, BLOCK KP, LAKE OF THE WOODS
SUMMER HOMES (SUNSET)

LAKE OF THE WOODS

Application No. 38576
Permit No. 44162

LAKE OF THE
RESC
WHITE PINI
AVENIC AR

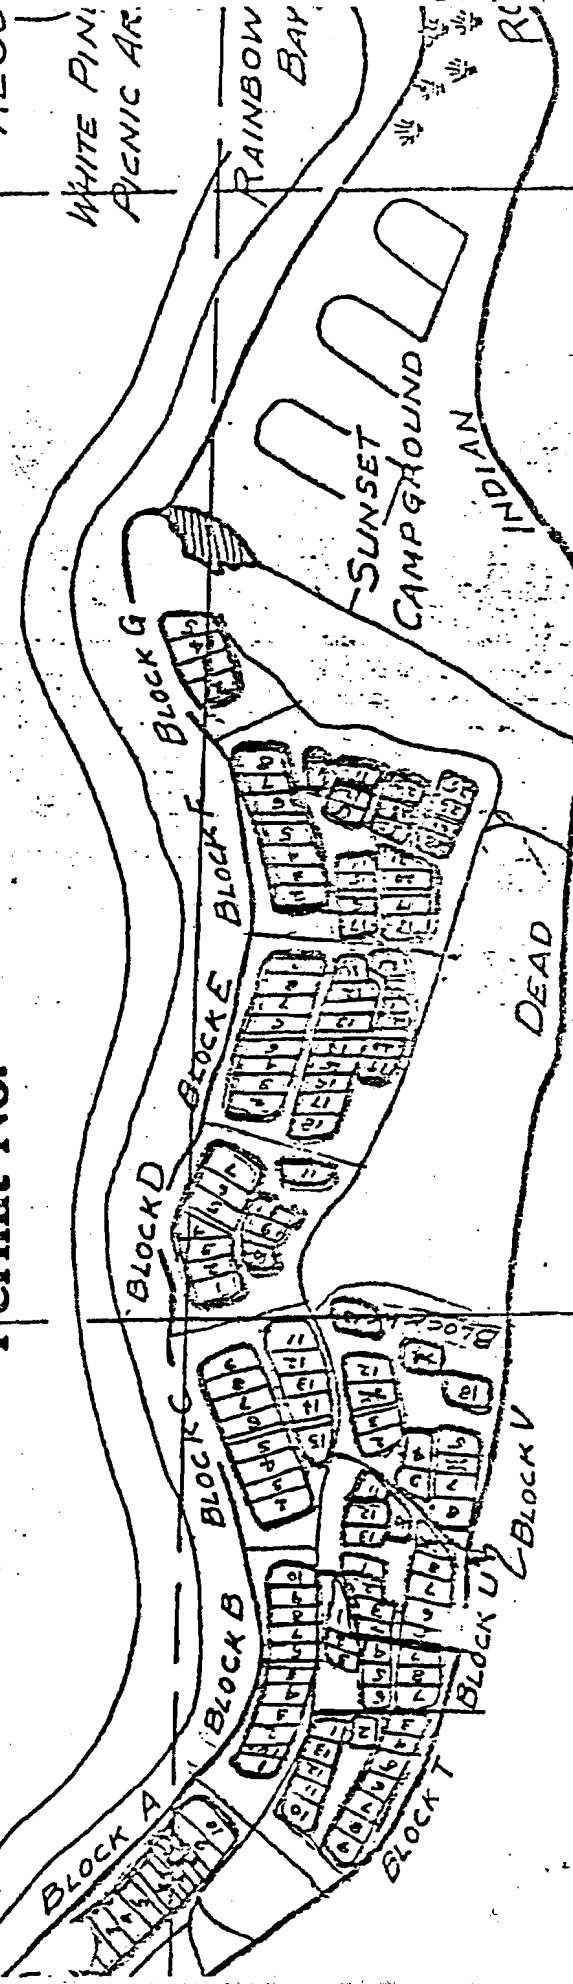

SUNSET
CAMPGROUND
INDIAN

44162
55789
RC