



44224  
58538  
HOMPSEN, K  
L. I., BLKN

Journal in Mar

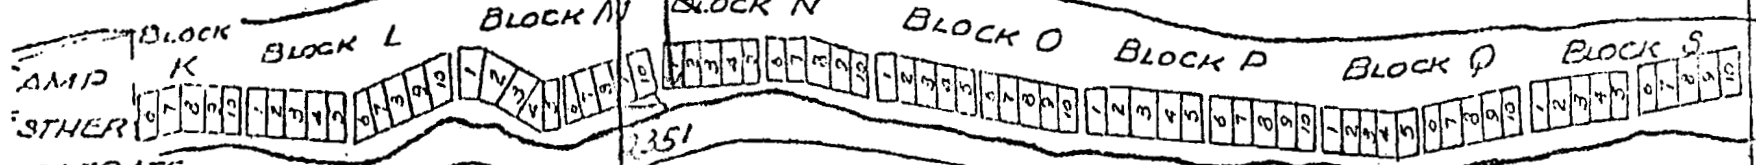

AMID  
STHER  
PLEGATE  
AMP FIRE GIRLS  
AMERICA

Point of Dimension, 1056' E + 235' N of the NW corner,  
SEC 10, T 31 S, R 15 E, W. POINT OF U.S. LOT 1, BLOCK N, AREA OF THE WOODS  
SUMMER HOME SURVEY.

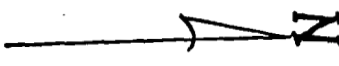

# LAKE OF THE WOODS

Application No. 58538  
Permit No. 44224

**RECEIVED**  
APR 16 1979  
WATER RESOURCES DEPT.  
SALEM, OREGON

LAKE OF THE WO  
RESORT

WHITE PINE  
PICNIC AREA

RAINBOW  
BAY

SUNSET  
CAMPGROUND

INDIAN

