

44533
16557
55791


SEC. 15
O'G'LAND

SEC. 10

SEC. 10

SEC. 5
O'G'LAND

Summer, Oct. 1979

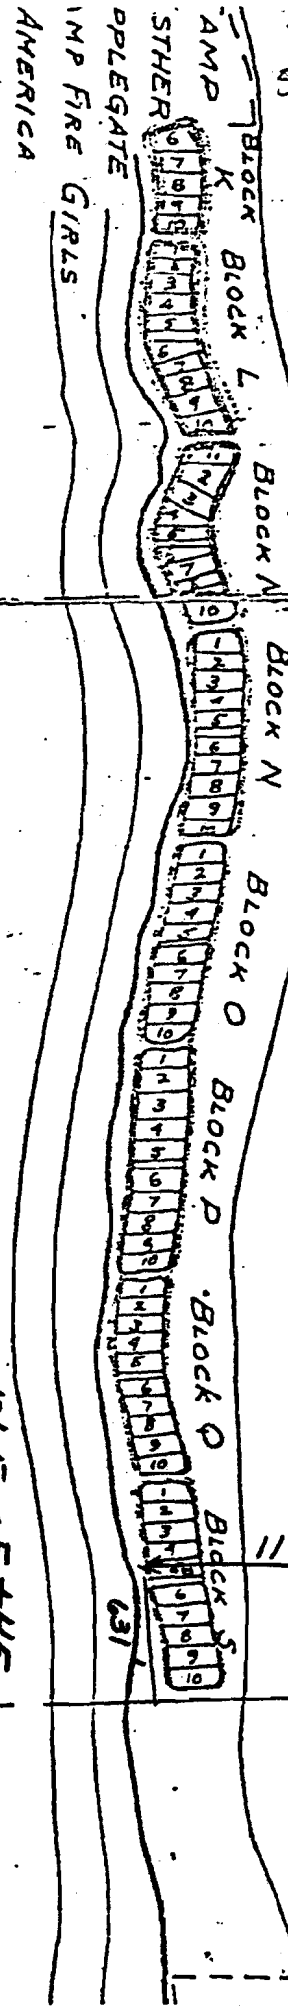


LAKE OF THE WOODS

Application No. 58830
Permit No. 44533

POINT OF DIVERSION - 631' S + 1148' E OF THE
NW CORNER OF SEC 10, T37S, R5E.
POINT OF USE - REG. RES. IN LOTS, BLS,
LAKE OF THE WOODS SUMMER HOME TRACT

JUN 22 1979

WRCES DEPT.
OREGON

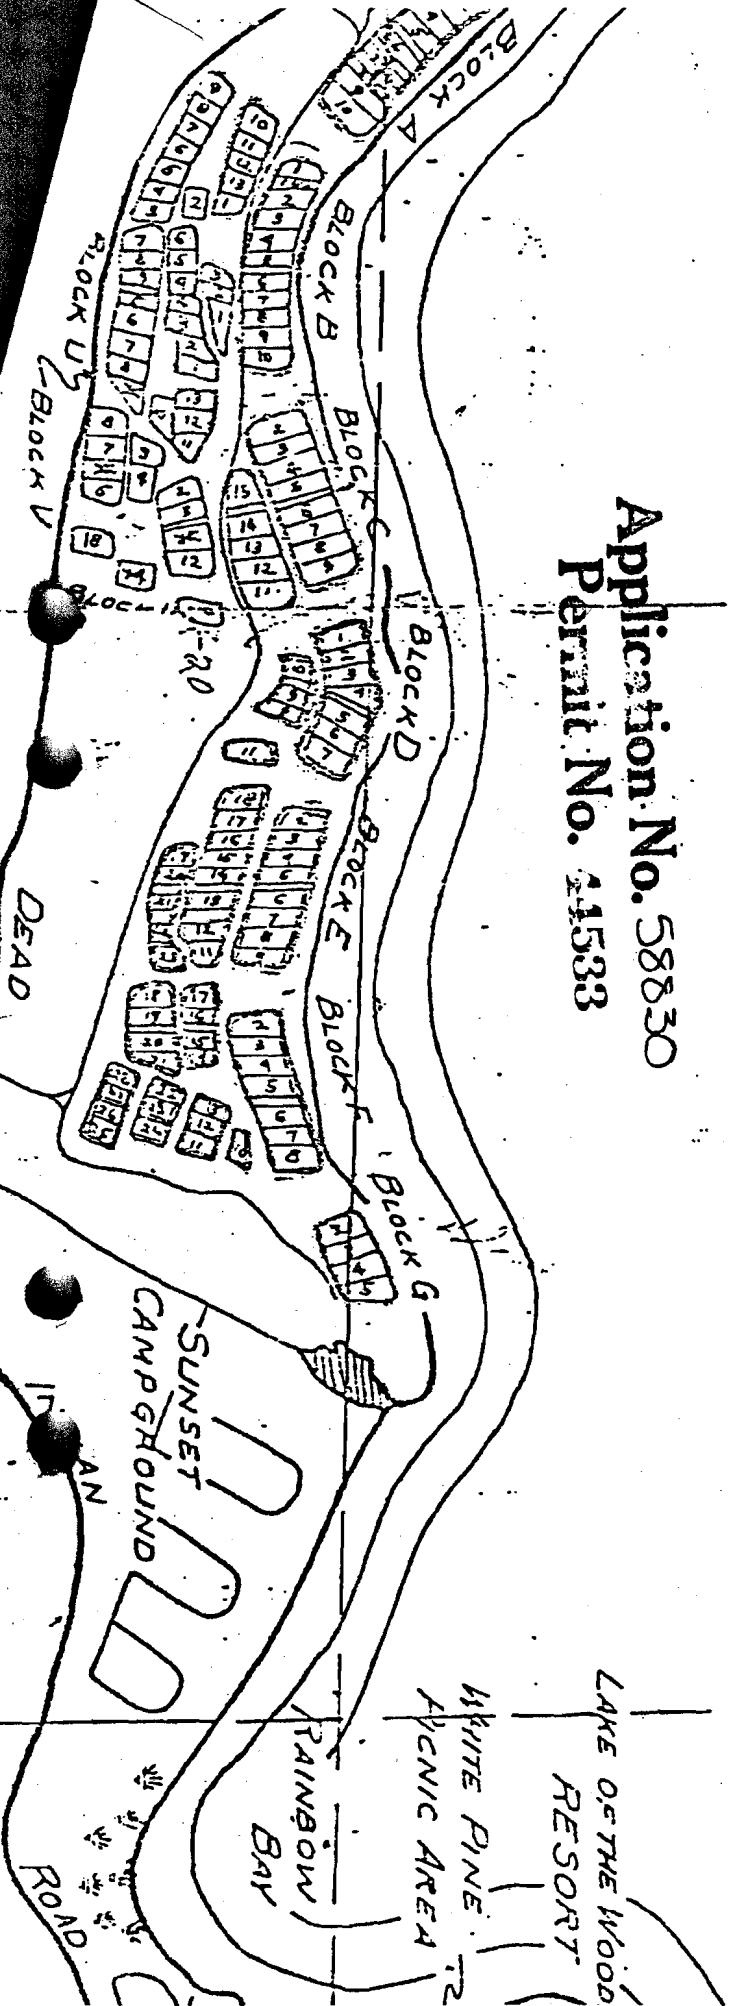

LAKE OF THE WOODS
RESORT

WHITE PINE

RAINBOW
BAY

SUNSET
CAMP GROUND

ROAD