



R.5E.


 Area of Use
 Scale 1" = 2000'



DIVERSION POINT
 LOT 2 SECTION 5
 T.37S. R.5E.

T.37S.

T.38S.

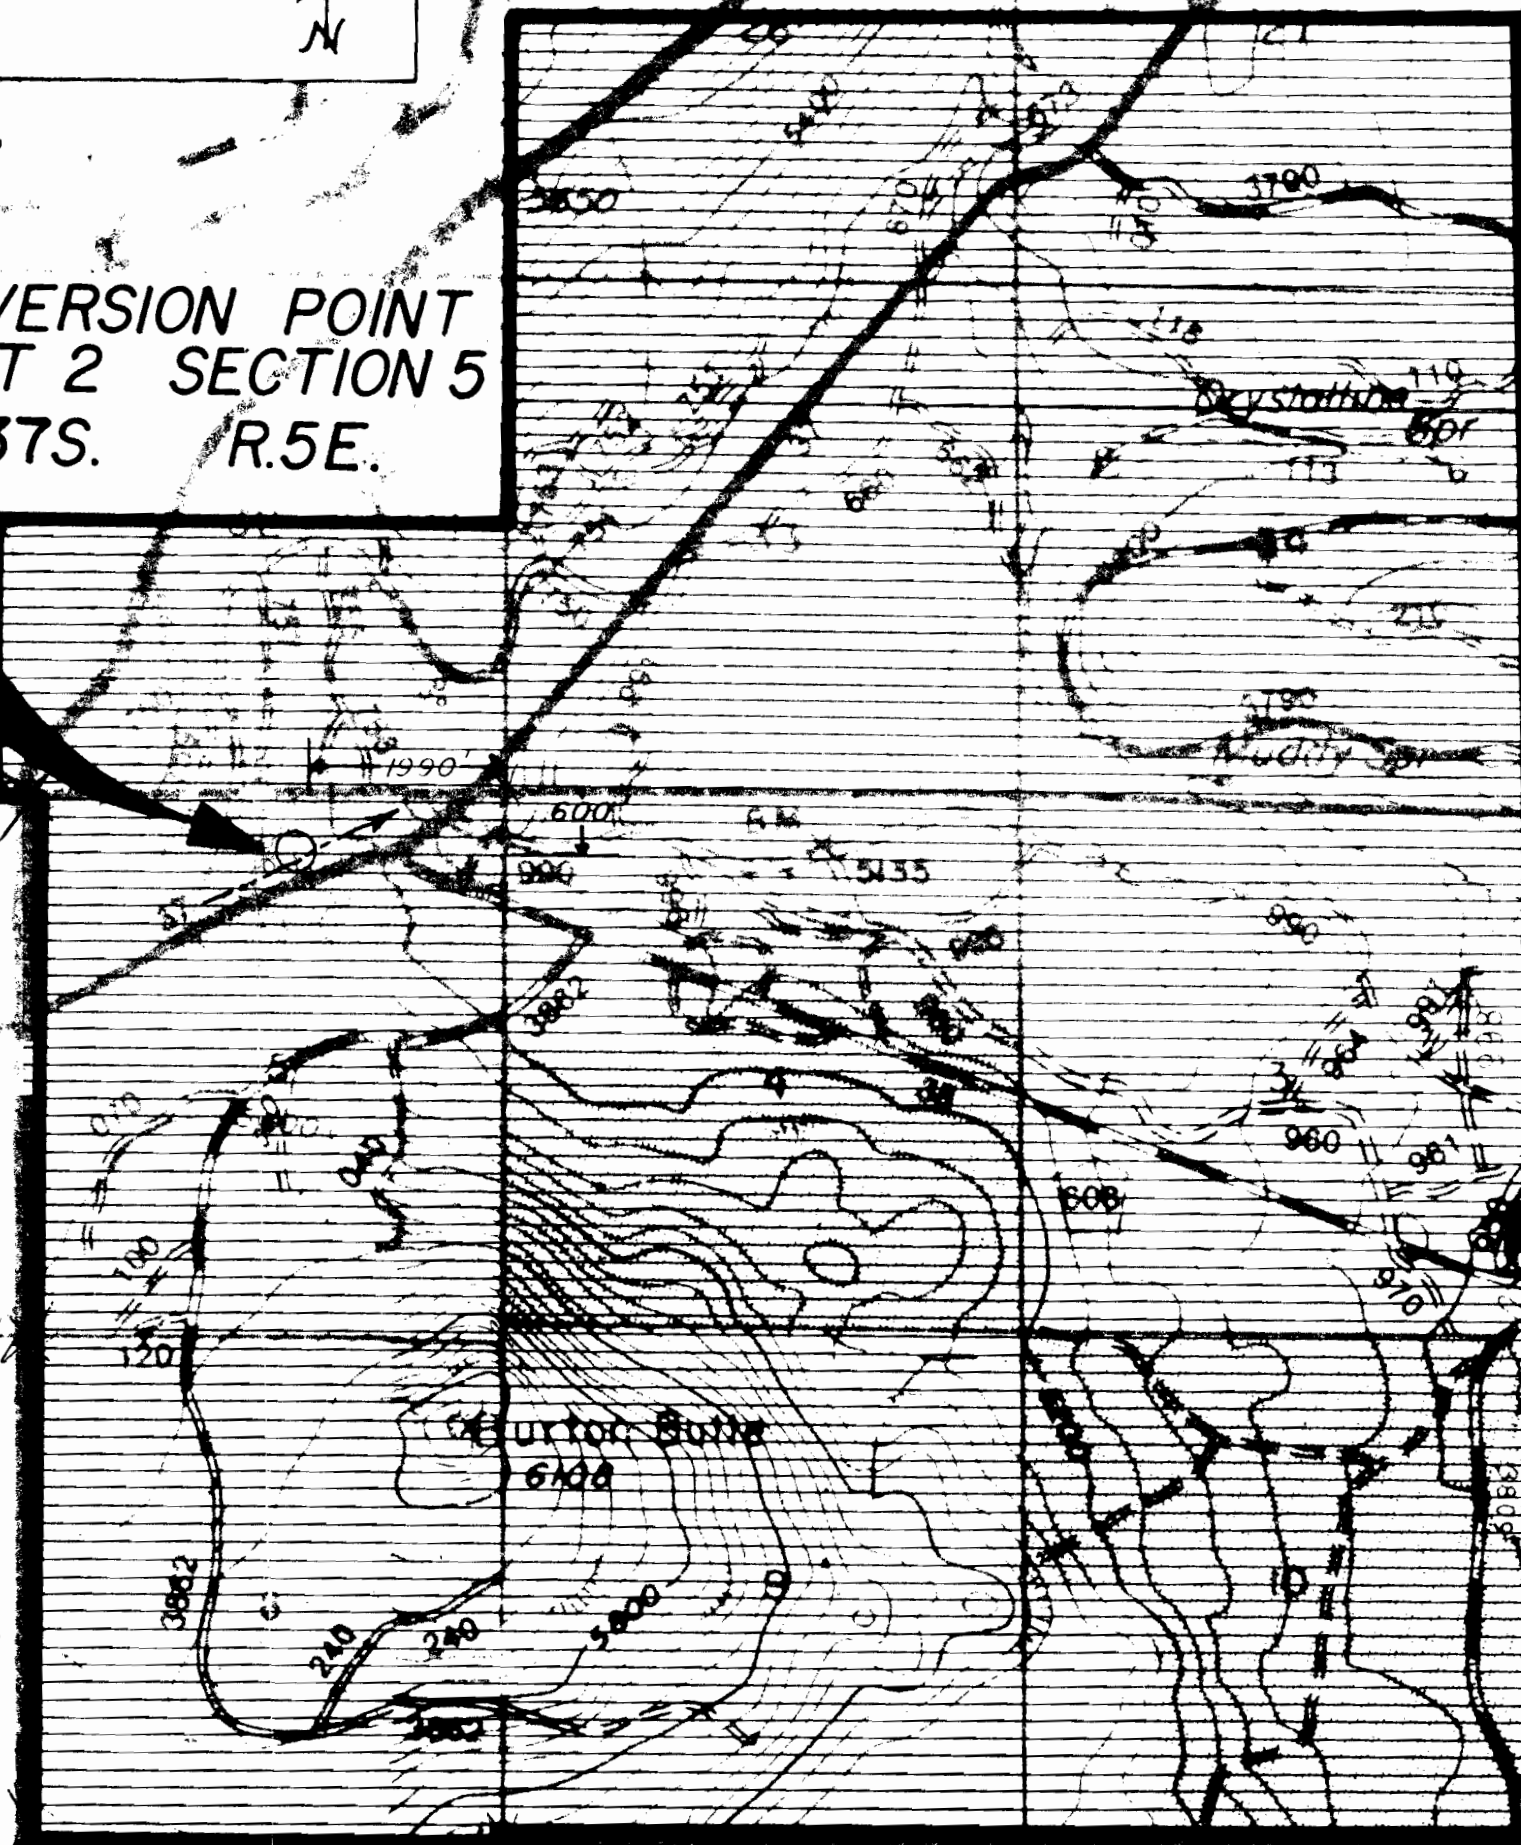

64583
48623