


T. 30 S., R. 16 E., W.M.

SCALE: 1" = 1320'

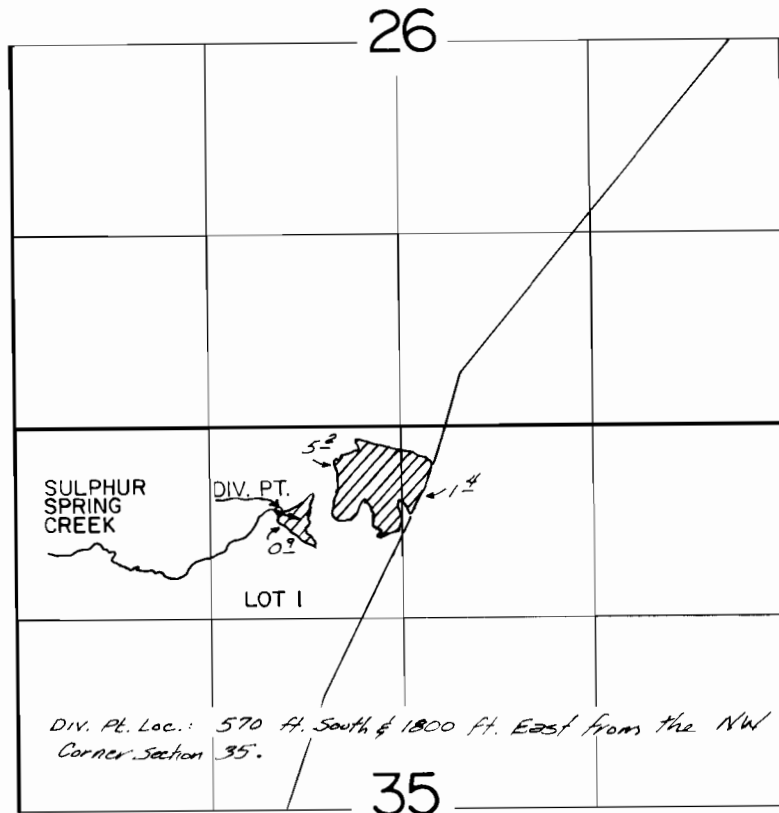

FINAL PROOF SURVEY
UNDER

Application No. 53792... Permit No. 40162.....

IN NAME OF

JESS H. PENINGTON

Surveyed AUG. 15 1985, by B.W. BISHOP.....