


T.18S.,R. 5W.,W.M.

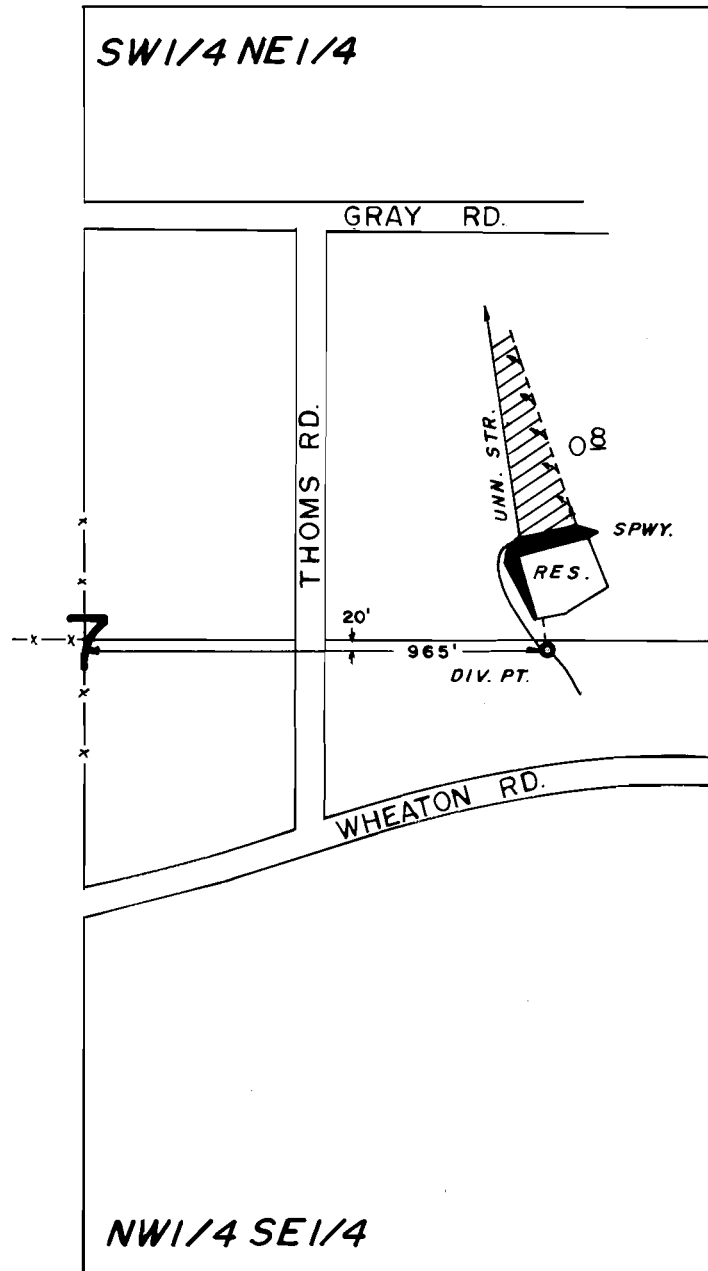

SCALE-1"=400'

FINAL PROOF SURVEY

UNDER

R-53289 R-6331
Application No. 53304.. Permit No. 39551.....
IN NAME OF

JOHN A. REED

Surveyed June...27. 1979., by S.C. BROWN.....