


T.19S. R.12W. W.M.

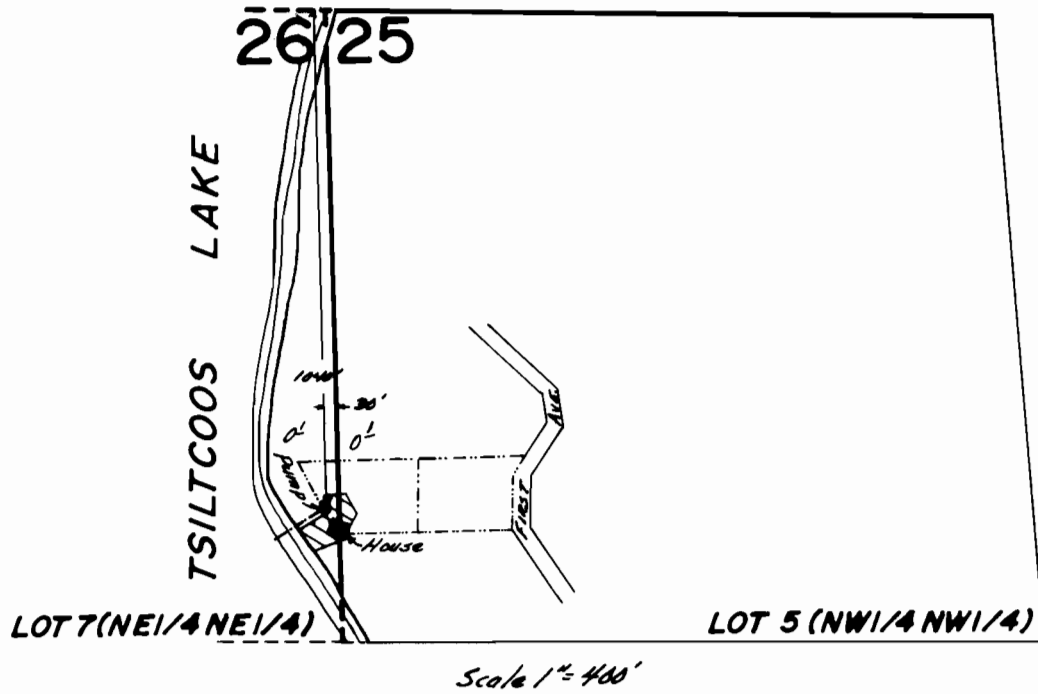

FINAL PROOF SURVEY UNDER

Application No. 49325.. Permit No. 367.26.....
IN NAME OF

RAY A. & MARCELLA M. CARNES

Surveyed AUG...8... 1979., by S.C. BROWN.....