


# T.18S., R.11W., W.M.

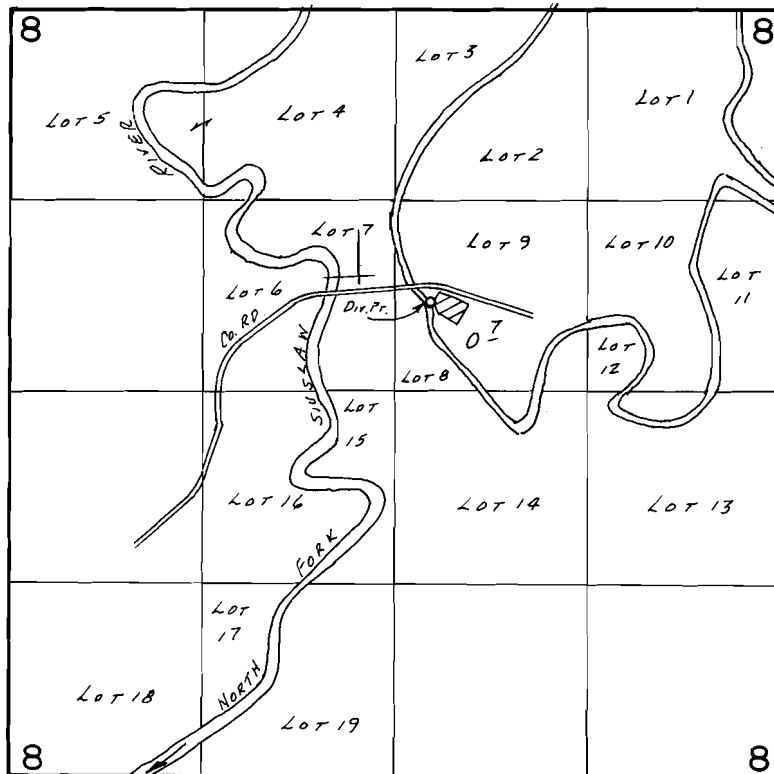

Dir. Pr. Loc.: 2010'S. & 250'E. FROM N 1/4 COR. SEC. 8.

SCALE: 1" = 1320'

## FINAL PROOF SURVEY UNDER

Application No. 55191... Permit No. 41610.....  
IN NAME OF

.....ROBERT McCAIN.....

Surveyed Sept. 25, 1985, by T.M. WARREN.....  
July 7, 1986 B.W. BISHOP

11/26/06  
BWB