


Range

11 E.W.M.

APP-9567

Per. - 6322

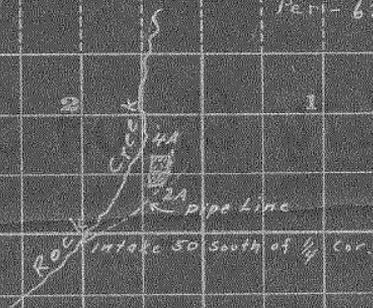

4

3

2

1

9

10

11

12

16

15

14

13

22

23

24

STATE ENGINEER
REGISTERED

JUL 15 1924


28

27

26

25