


T. 17 S., R. 10 W., W.M.

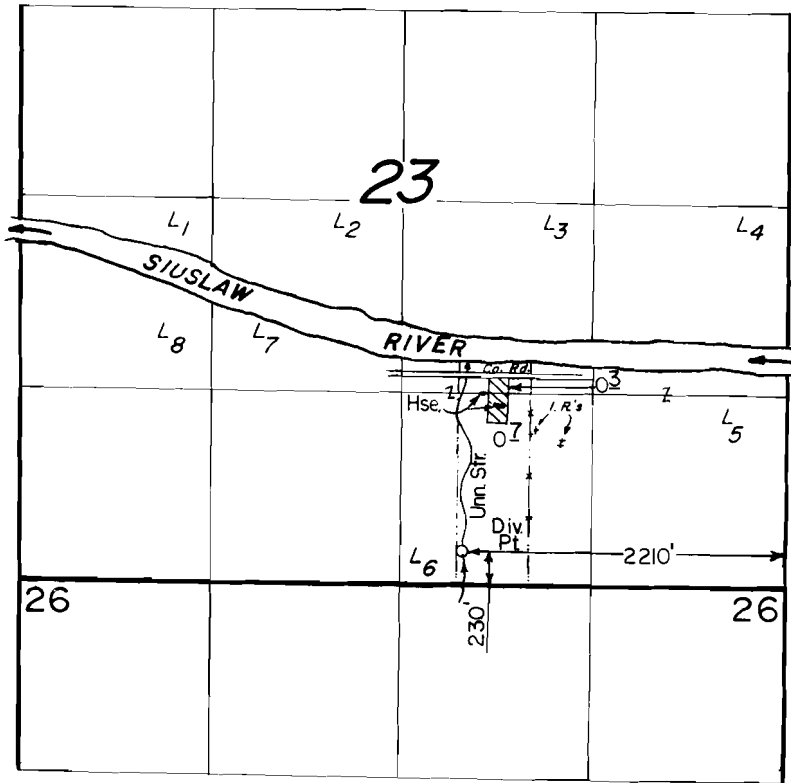

Scale: 1" = 1320'

**FINAL PROOF SURVEY**  
UNDER

Application No. 58487. Permit No. 44344....  
IN NAME OF

CHARLES E. & VICKI L. DAVIS

Surveyed Sept. 24 1985, by T. Warren.....