


T. 15S., R. 12 W., W.M.

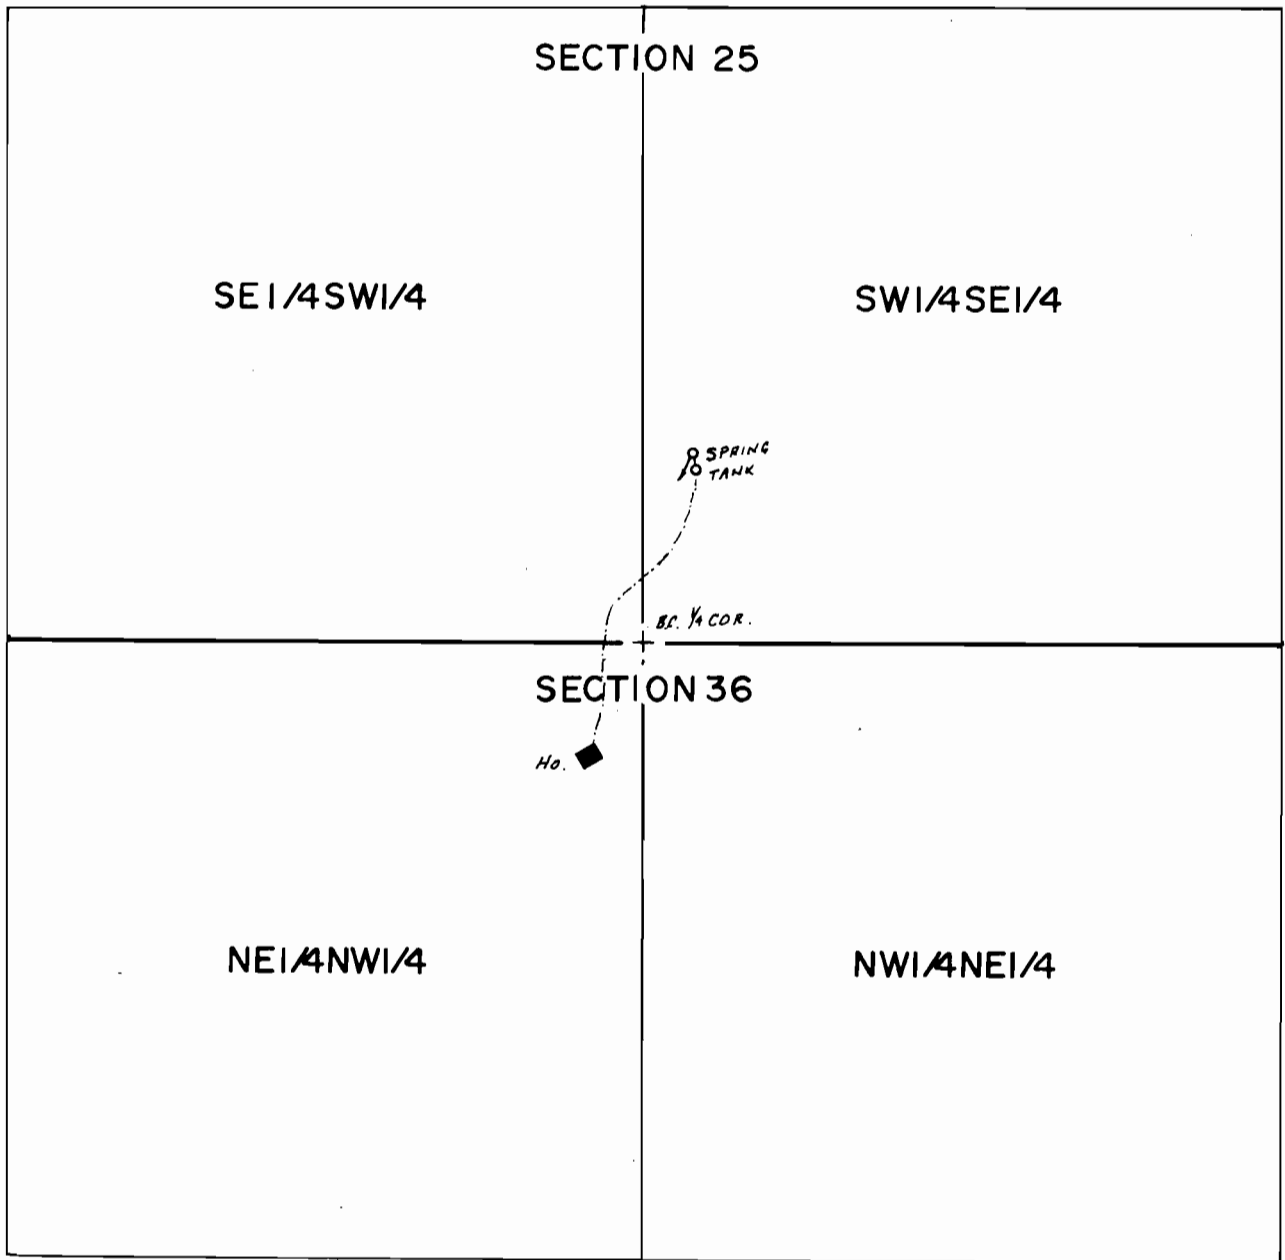

SPRING LOC.: 400' N. & 100' E. FROM S 1/4 COR. SEC. 25

SCALE: 1" = 400'

FINAL PROOF SURVEY UNDER

Application No. 59542. Permit No. 44774.....
IN NAME OF

HANS & J. KARIN RADKE.....

Surveyed July 11, 1986, by B.W. BISHOP.....

11/26/86
BWB

PTS 1986B