


T. 19S., R. 12W., W.M.

SECTION 2

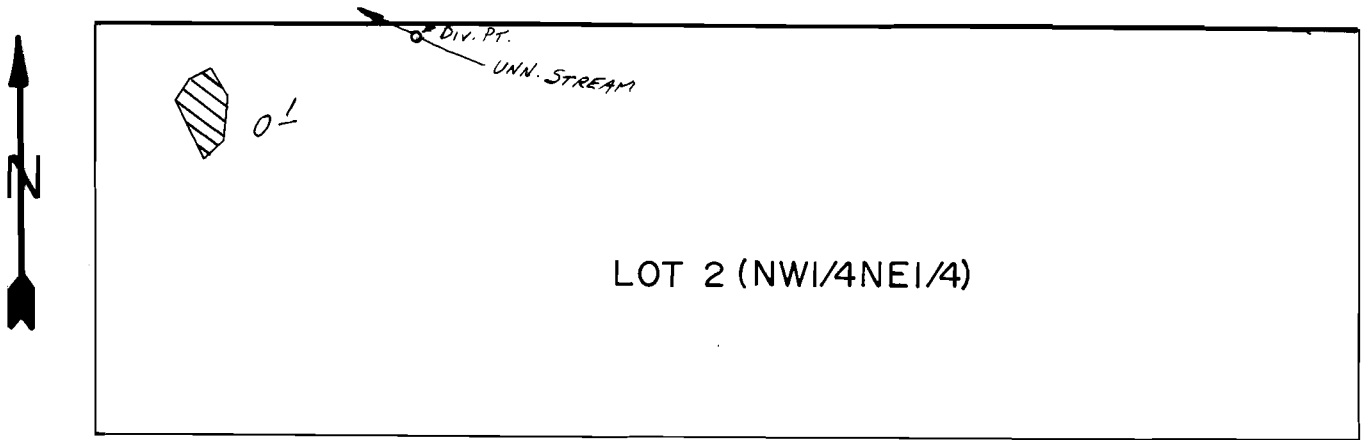

DIV. PT. LOC.: 10'S. & 335'E. FROM N 1/4 COR. SEC. 2.

SCALE: 1"=200'

**FINAL PROOF SURVEY**  
UNDER

Application No. 61488.. Permit No. 45686.....

IN NAME OF

.....VAL & STEVE HAMILTON.....

Surveyed July 9..... 1986., by B.W. BISHOP.....

11/25/86  
BWB

PTS 1986B