


SW 1/4 Sec. 30 T.19S. R.11W.W.M.

LANE COUNTY

1"=200'

See Map 19 11 30

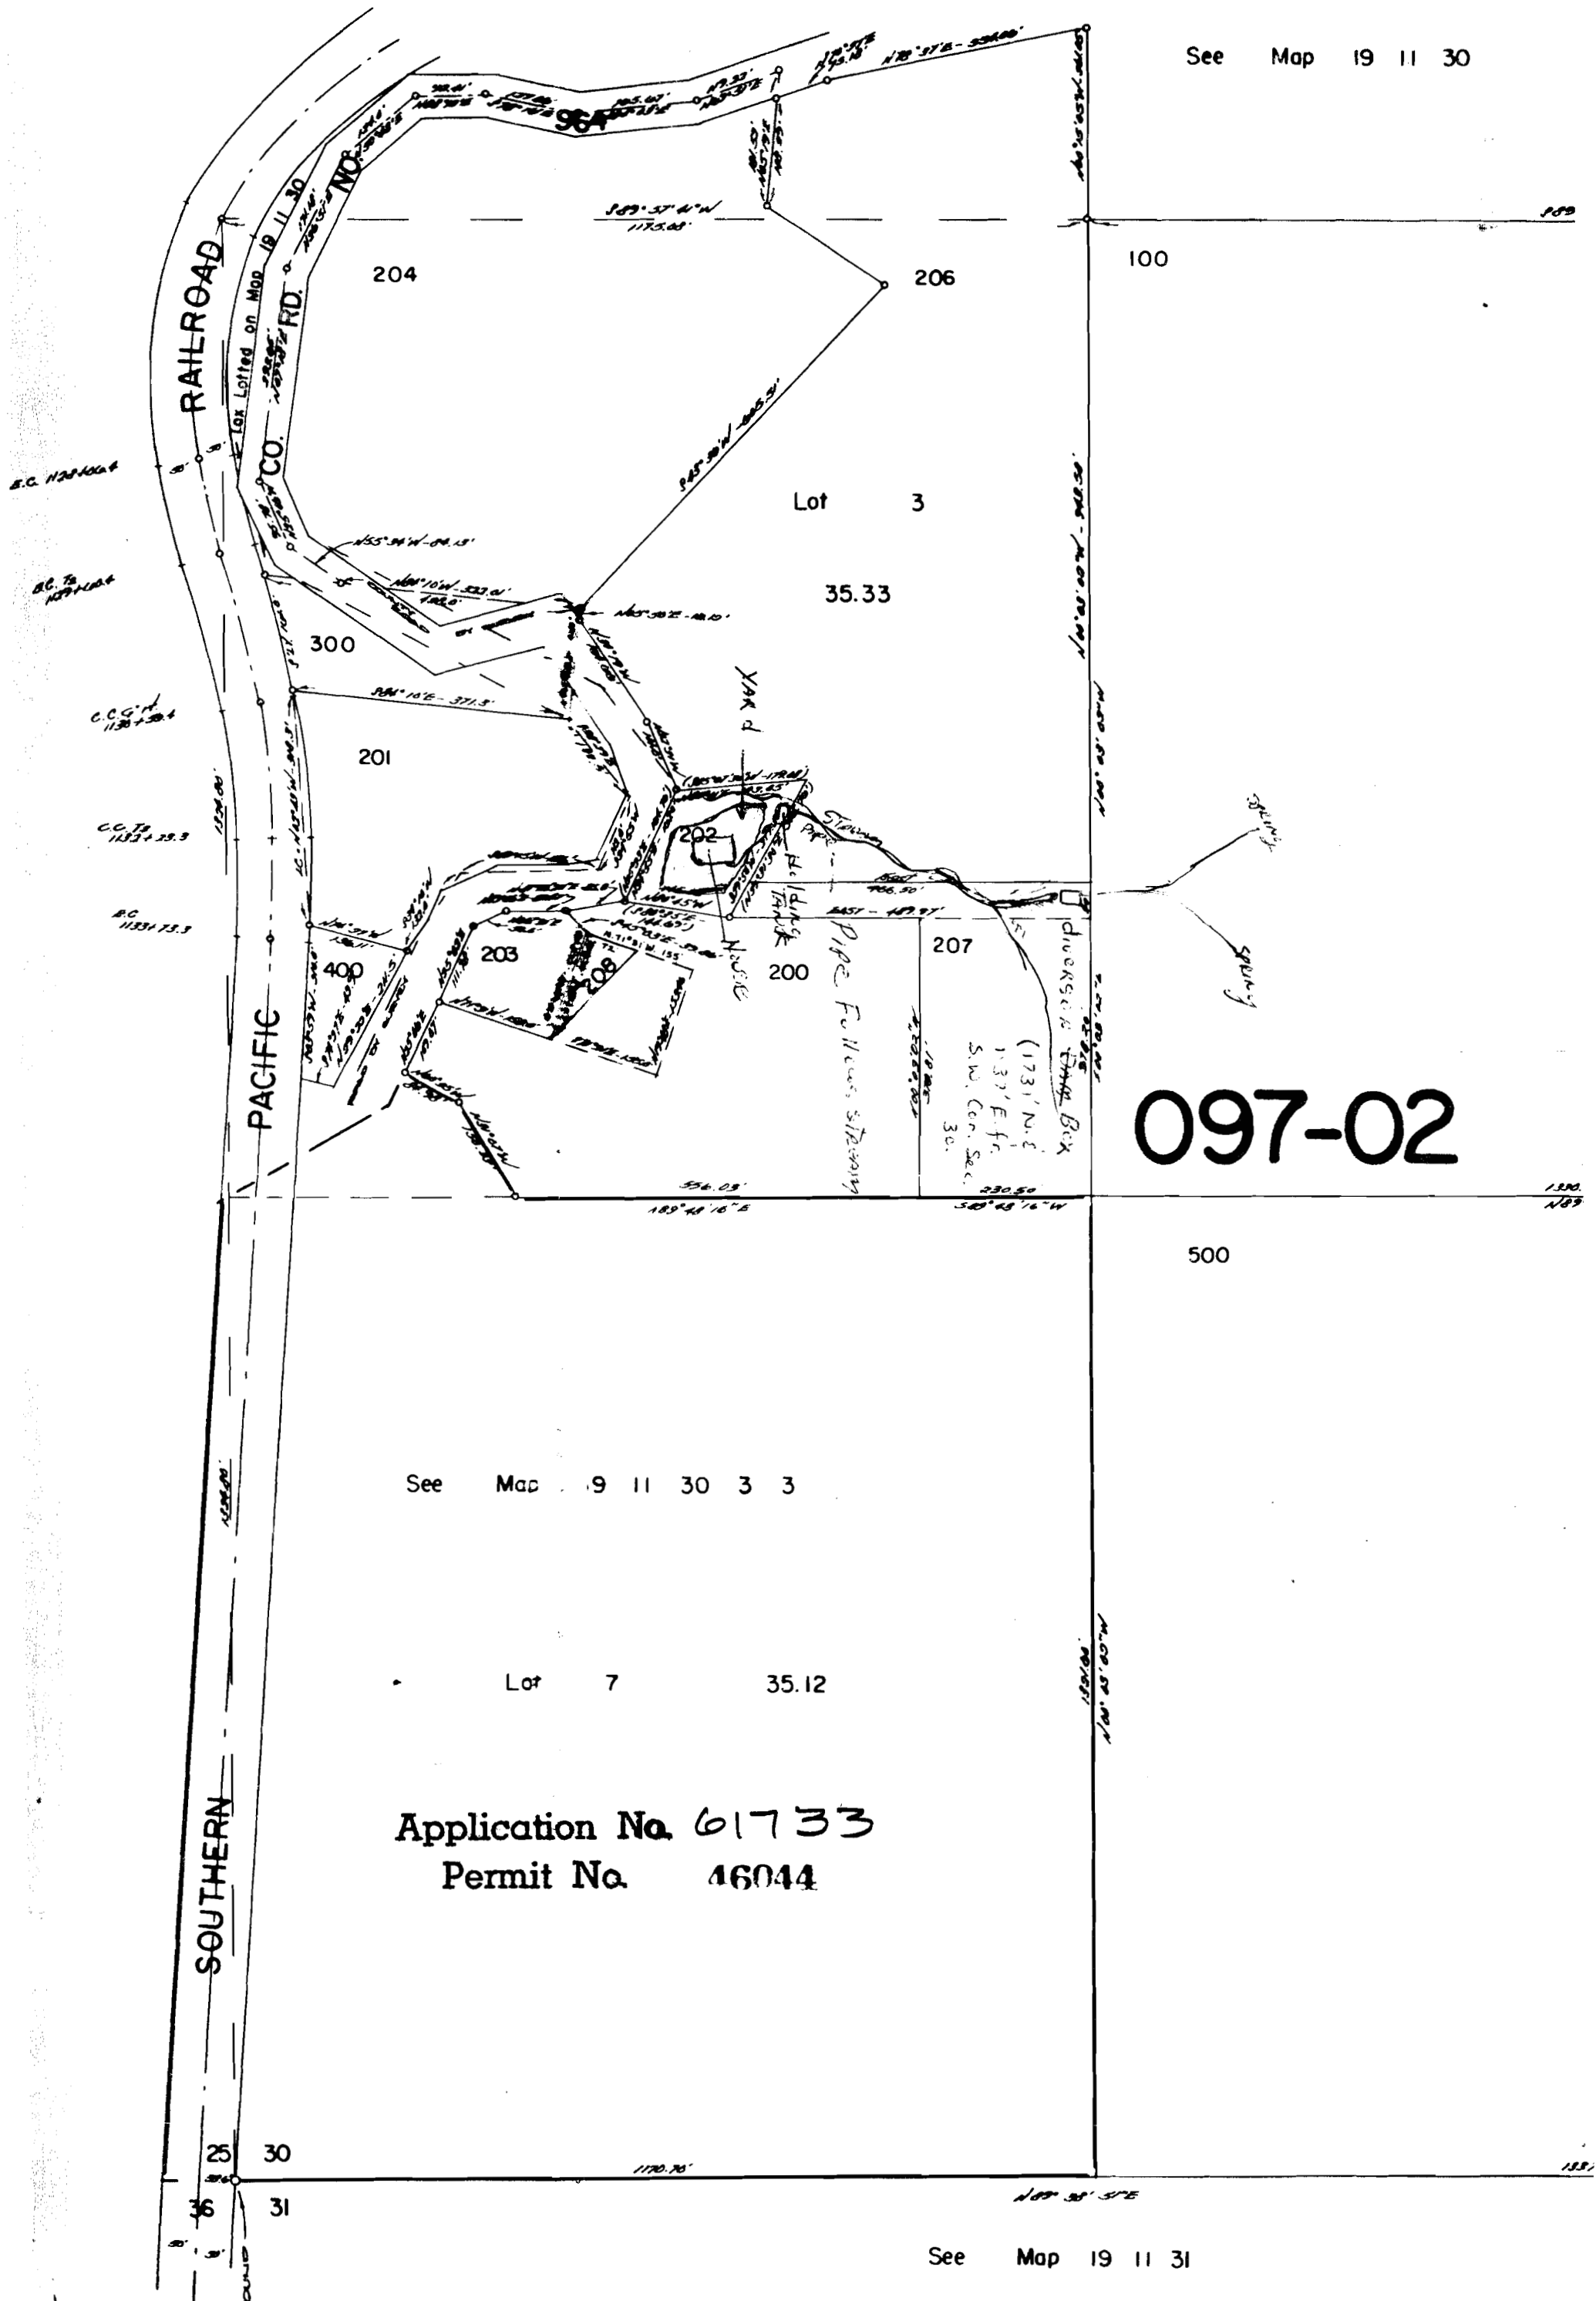

097-02

See Map 19 11 30 3 3

Lot 7 35.12

Application No. 61733

Permit No. 46044

See Map 19 11 31