


T.15S., R.12W., W. M.

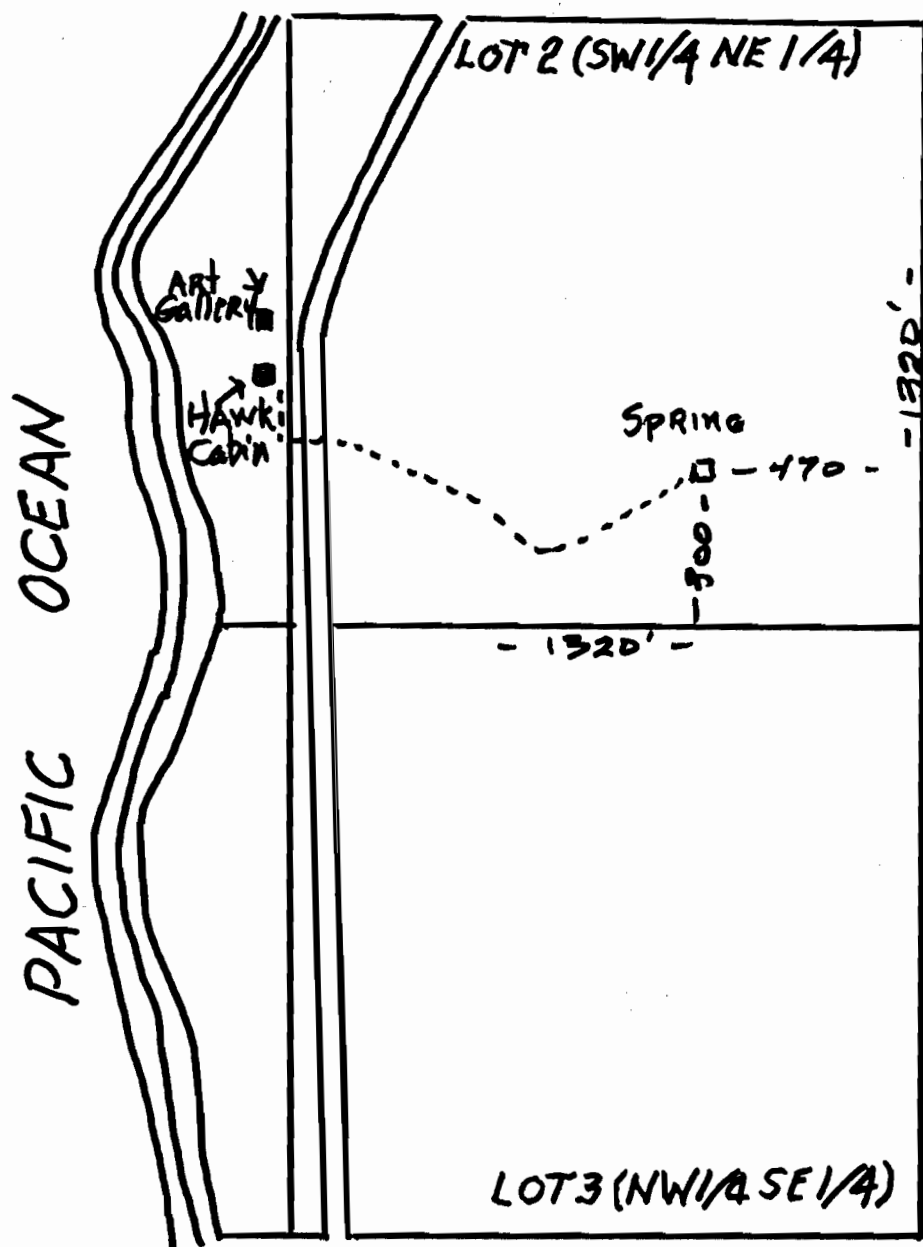

SECTION 34

Application No. 68374
Permit No. 49389

Scale 1" = 400'