


T.IOS.,R.IW.,W.M.

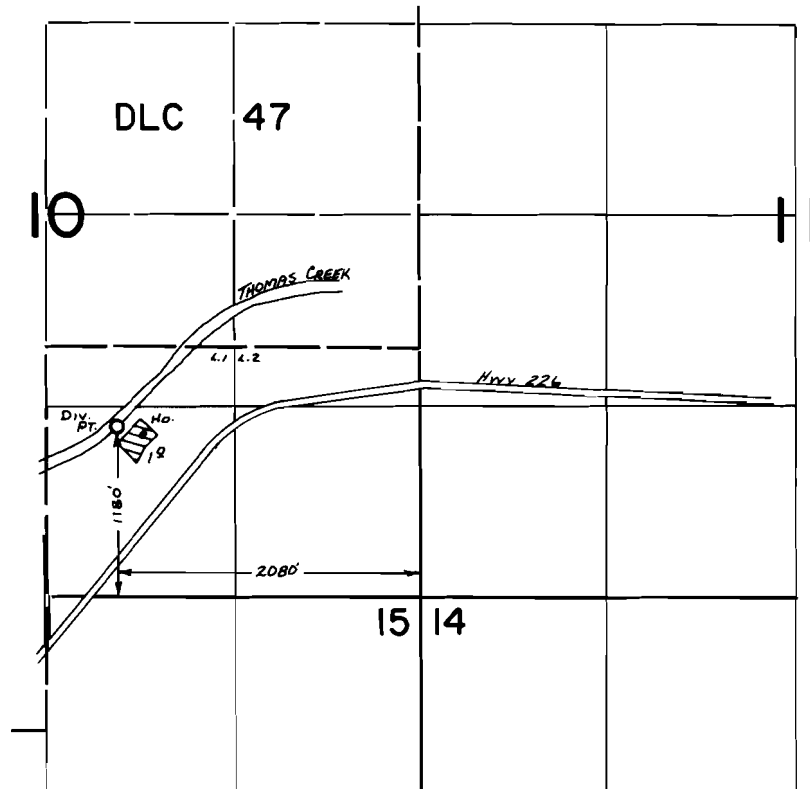

FINAL PROOF SURVEY UNDER

Application No. ...5389!... Permit No. ...40210.....

IN NAME OF
 IRVIN H. JACOBS
 HARVEY A. KEUDELL
WILLIAM D. & MARY D. STOVER.....

Surveyed June...3... 19.82, by L.M. TOLL.....