


T.13S., R.1E., W.M.

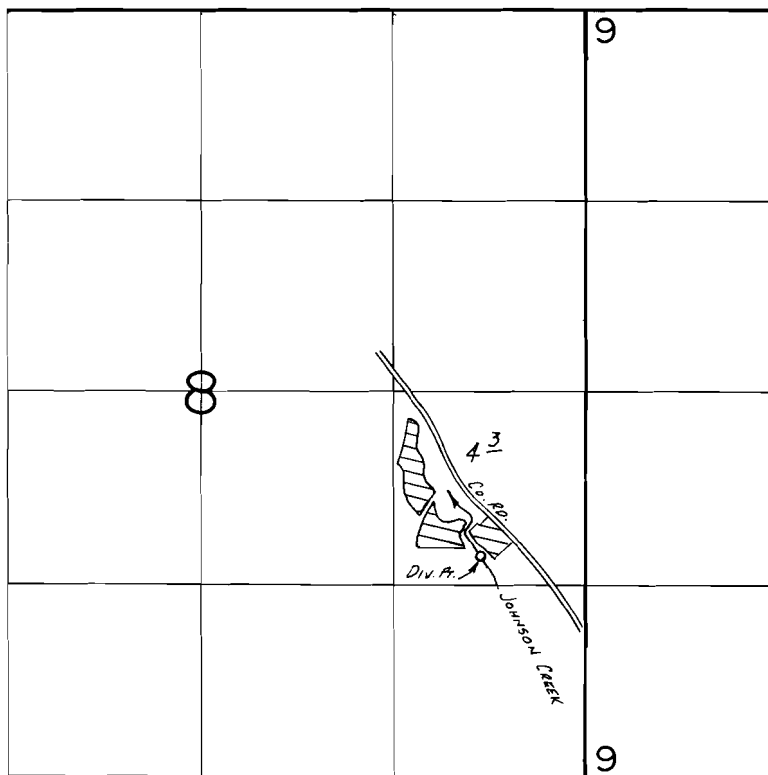

Div. Pt. Loc.: 1520' N. & 720' W. FROM SE COR. SEC. 8.

SCALE: 1"=1320'

FINAL PROOF SURVEY UNDER

Application No. 58667 Permit No. 44663.....
IN NAME OF

WILLIAM A. RAUCH.....

Surveyed June 17 1986, by B.W. BISHOP.....

11/20/86
KWB

41043-278-88R