


# T.14S.,R.1W.,W.M.

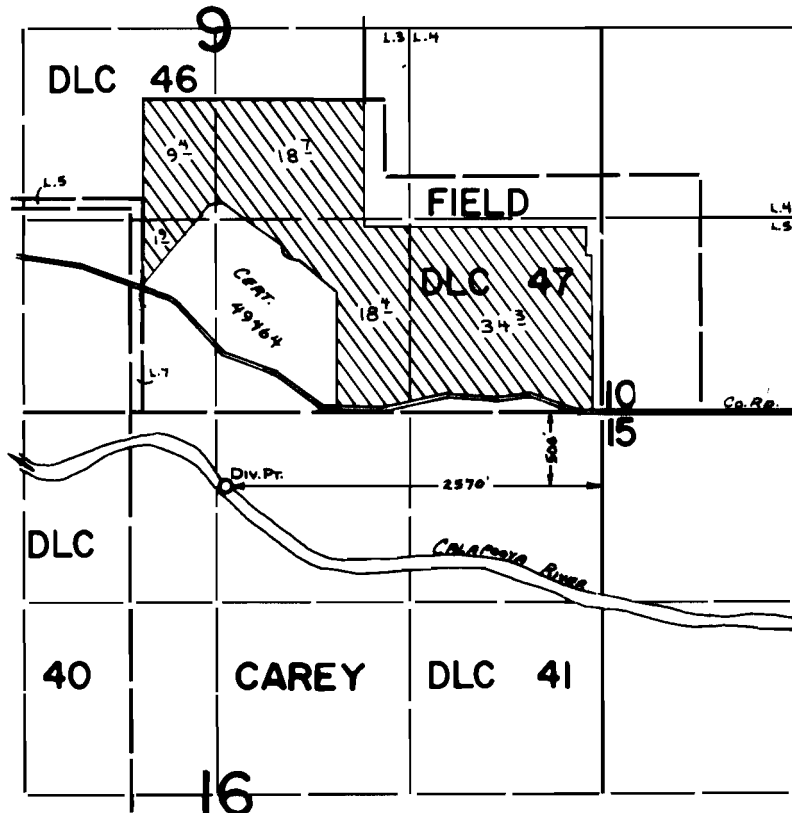

## FINAL PROOF SURVEY UNDER

Application No. 59389.. Permit No. 44937.....  
IN NAME OF

.....EDWARD M. GRAVILLE.....

Surveyed April 22, 1982., by L. M. TOLL.....