


T.14 S., R.1 W., W.M.

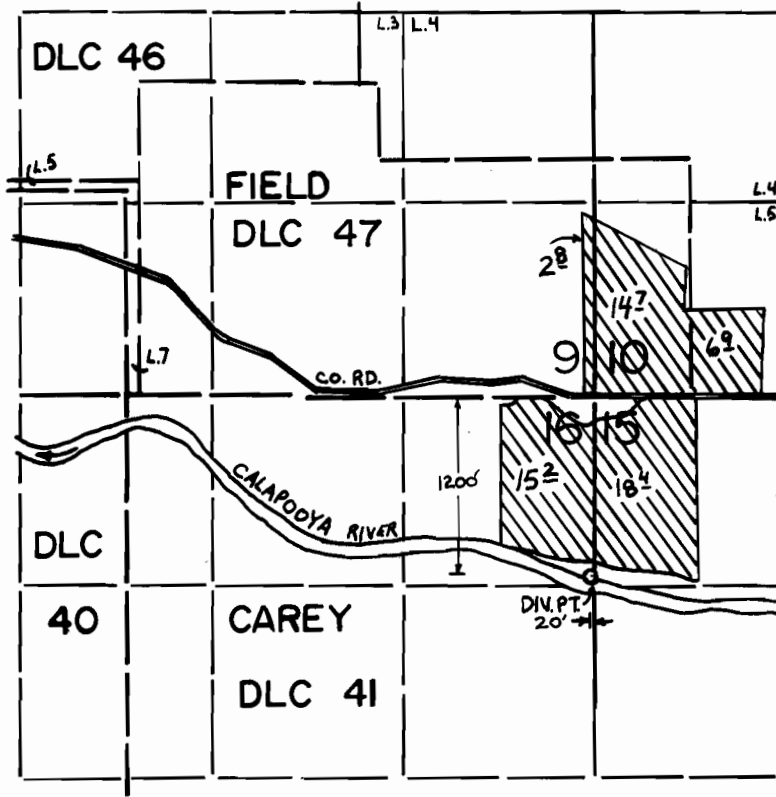

SCALE 1" = 1320'

FINAL PROOF SURVEY
UNDER

Application No. 68082... Permit No. 48488
IN NAME OF

..... **EDWARD M. GRAVILLE**

Surveyed June 10, 1986, by B. Bishop.....