


T.11S., R.1W., W.M.

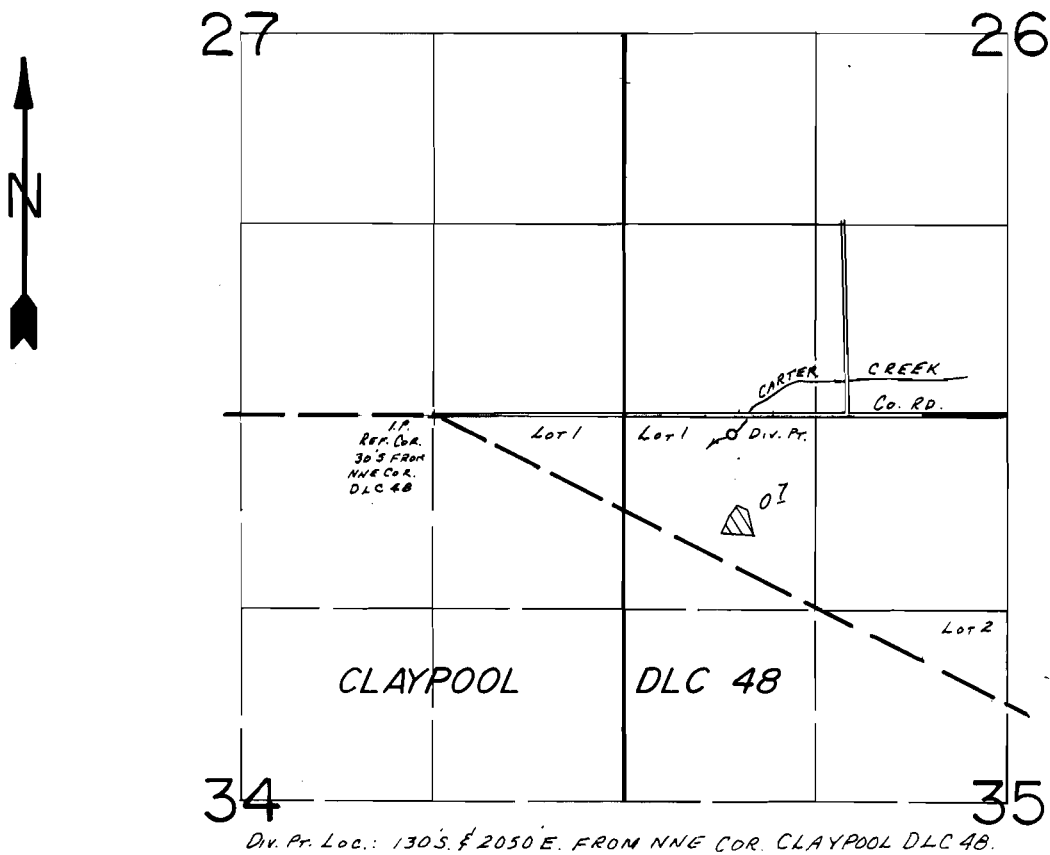

SCALE: 1"=1320'

FINAL PROOF SURVEY
UNDER

Application No. 62325... Permit No. 46415...
IN NAME OF

JOHN D. & EVALYN M. NOBLE.

Surveyed MAY 12... 19.86, by B.W. BISHOP

10/15/86
BWB
PTS 1986B