
90684

T.9S., R.1W. & R.1E., W.M.

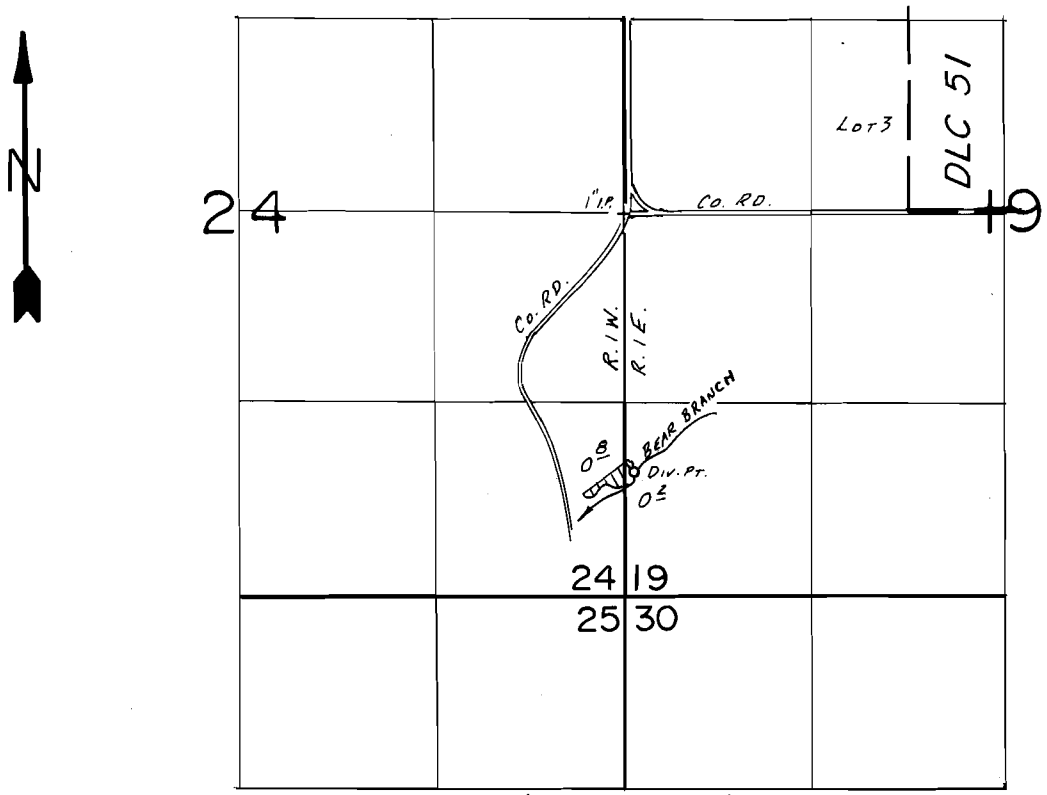

DIV. PT. LOC.: 1780'S. & 60'E. FROM W 1/4 COR. SEC 19

SCALE: 1" = 1320'

FINAL PROOF SURVEY
UNDER

Application No. 62355 **Permit No.** 46512
IN NAME OF

RICHARD S. VOHS

Surveyed May 28 19 86, **by** B.W. BISHOP

11/13/86
BWB

41043-278-99L