


T. 9S., R. 3E., W.M.

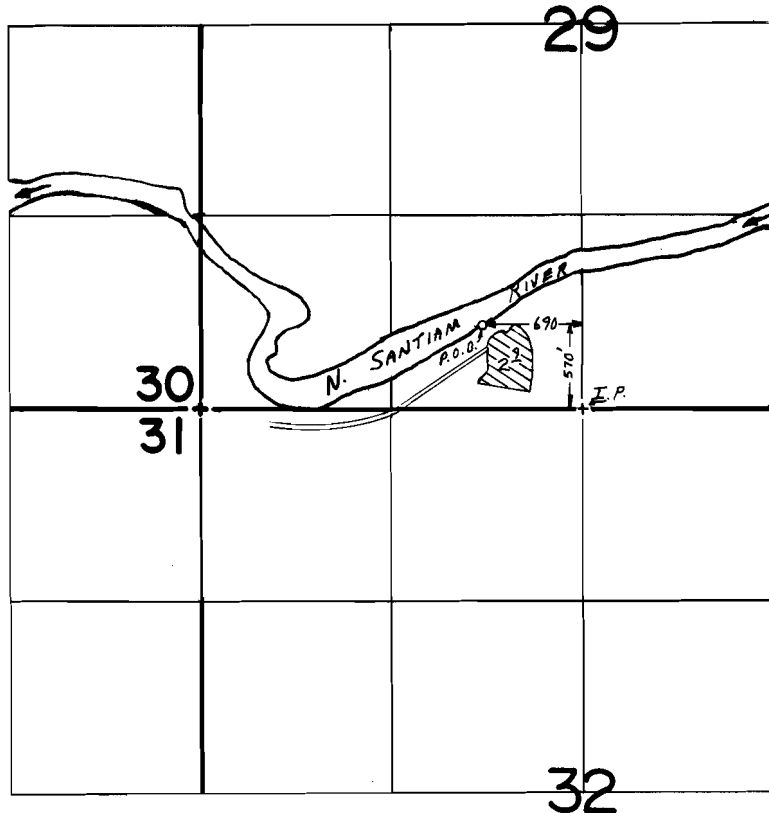

Scale : 1" = 1320'

FINAL PROOF SURVEY
UNDER

Application No. 63751.... Permit No. 47258.....
IN NAME OF

CITY OF MILL CITY.....

Surveyed May...7.... 1986., by T. Warren.....