


T.13 S., R.1 W., W. M.

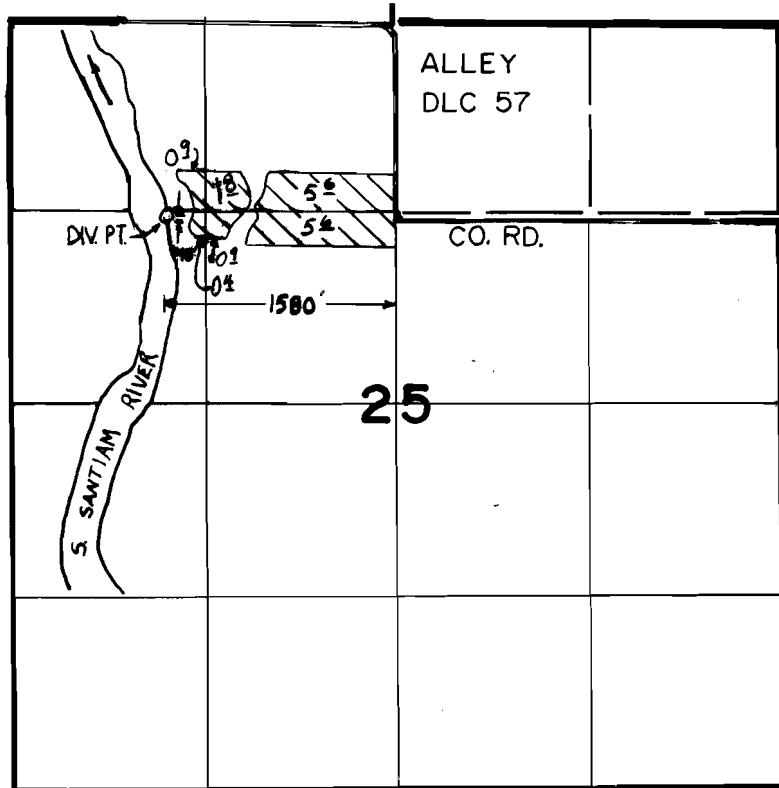

N
SCALE 1"=1320'

FINAL PROOF SURVEY
UNDER

Application No. 63844 Permit No. 47313
IN NAME OF

CHARLES E. CRAIN

Surveyed June 6, 1986, by B. Bishop