


T. 13 S., R. 1 E., W. M.

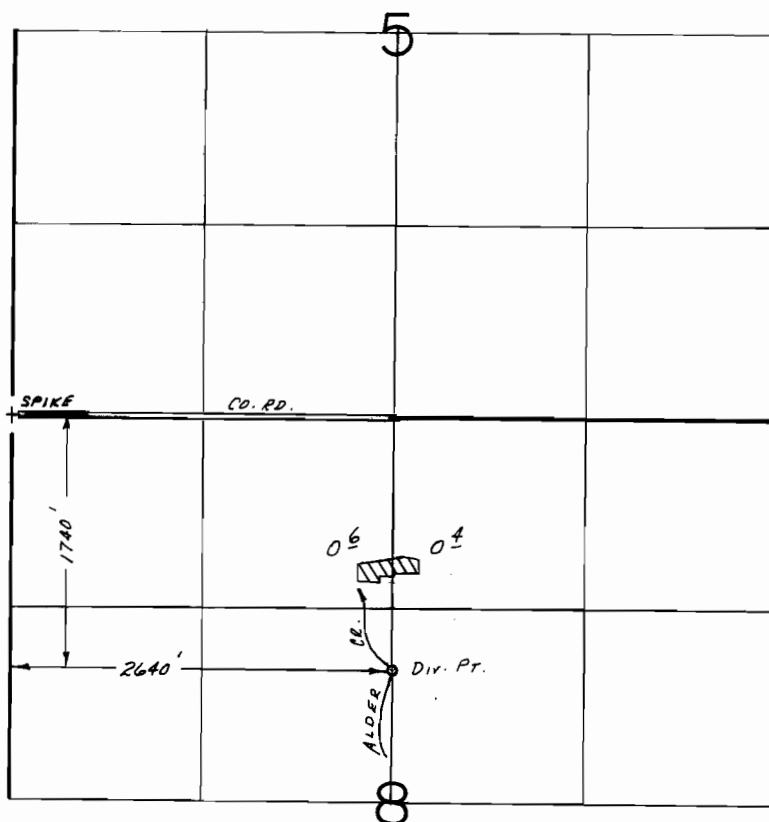

SCALE: 1" = 1320'

FINAL PROOF SURVEY UNDER

Application No. 65134 Permit No. 47578....
IN NAME OF

KAY G. & EILEEN F. SELEEN.....

Surveyed June 11.... 1986, by B.W. BISHOP.....