


T.19S.,R.42E.,W.M.

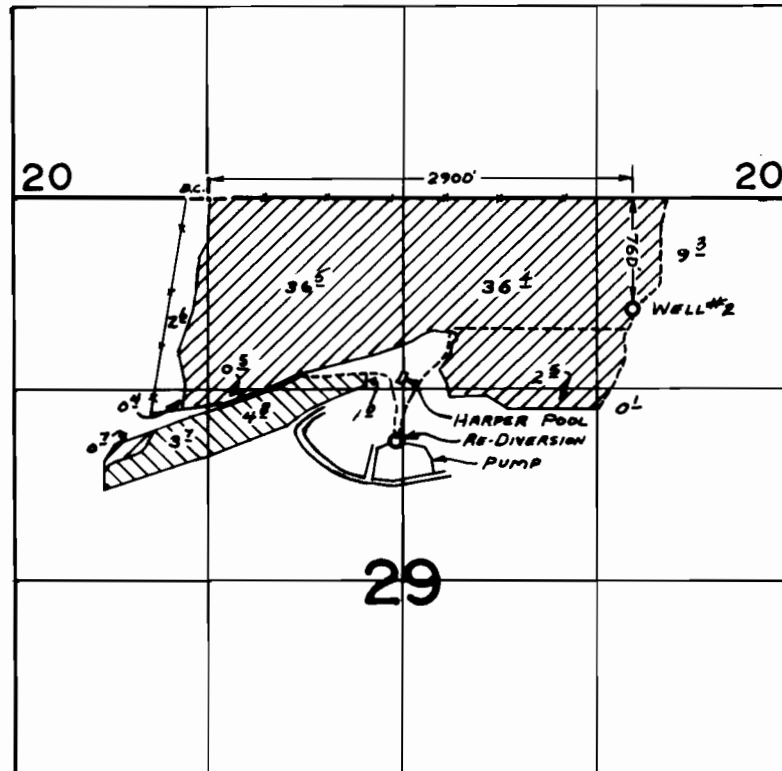

SUPPLEMENTAL



PRIMARY



FINAL PROOF SURVEY

UNDER

Application No. G-5754. Permit No. G-5540.
IN NAME OF

TOM J. DONALDSON

Surveyed Sept. 2 1981, by L. TOLL