


T. 7S., R. 1E., W.M.

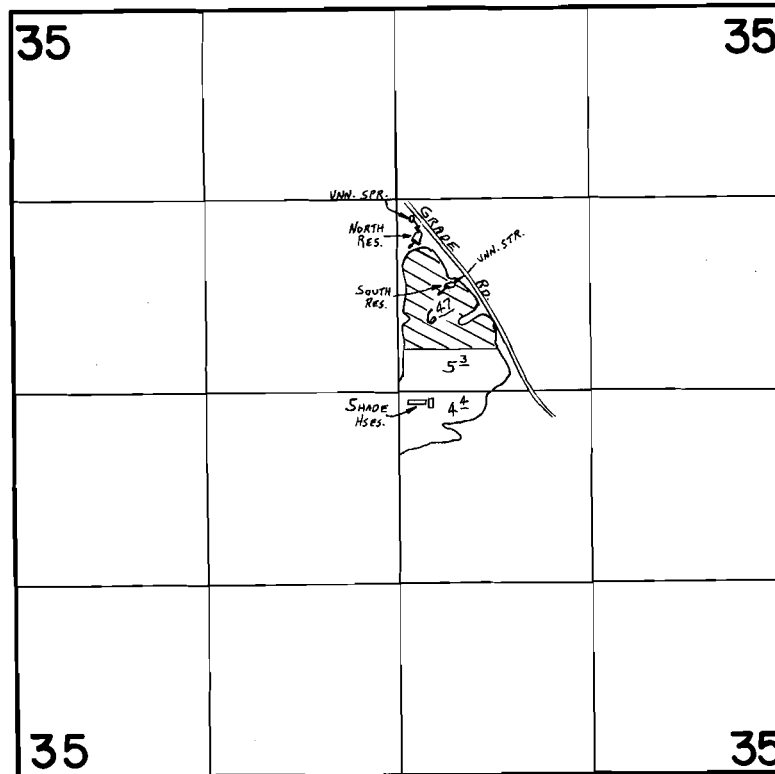

Dam #1 Loc.: 1050' N. & 140' E.

Dam #2 Loc.: 710' N. & 350' E., both from C. 1/4, Sec. 35

Scale: 1" = 1320'

FINAL PROOF SURVEY UNDER

R- 55859

R- 8485

Application No. 55860... Permit No. 46962.....

IN NAME OF

WILLIAM L. & JOAN K. STEFFEN

Surveyed April 28, 1986., by J. Warren.....

41047-178-14R +
ZOOM

T.M.W.