


T. 8 S., R. 1 W., W. M.

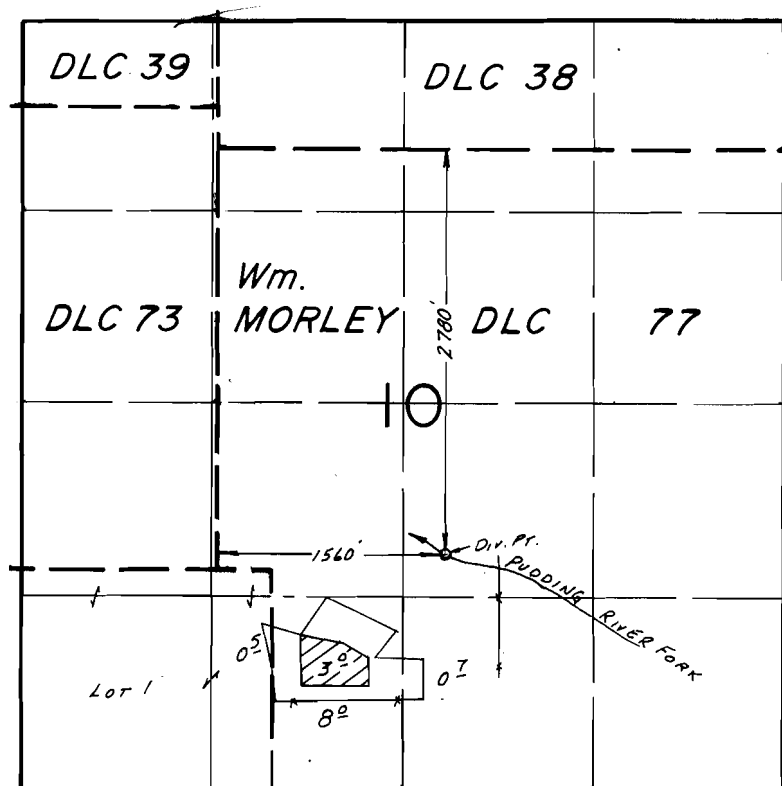

SCALE: 1"=1320'

FINAL PROOF SURVEY UNDER

Application No. 62253 Permit No. 46446
IN NAME OF

LARRY W. JEBOUSEK

Surveyed May 27, 1986, by B.W. BISHOP

11/10/86
BWB

PTS 1986B