


T. 9 S., R. 2 E., W. M.

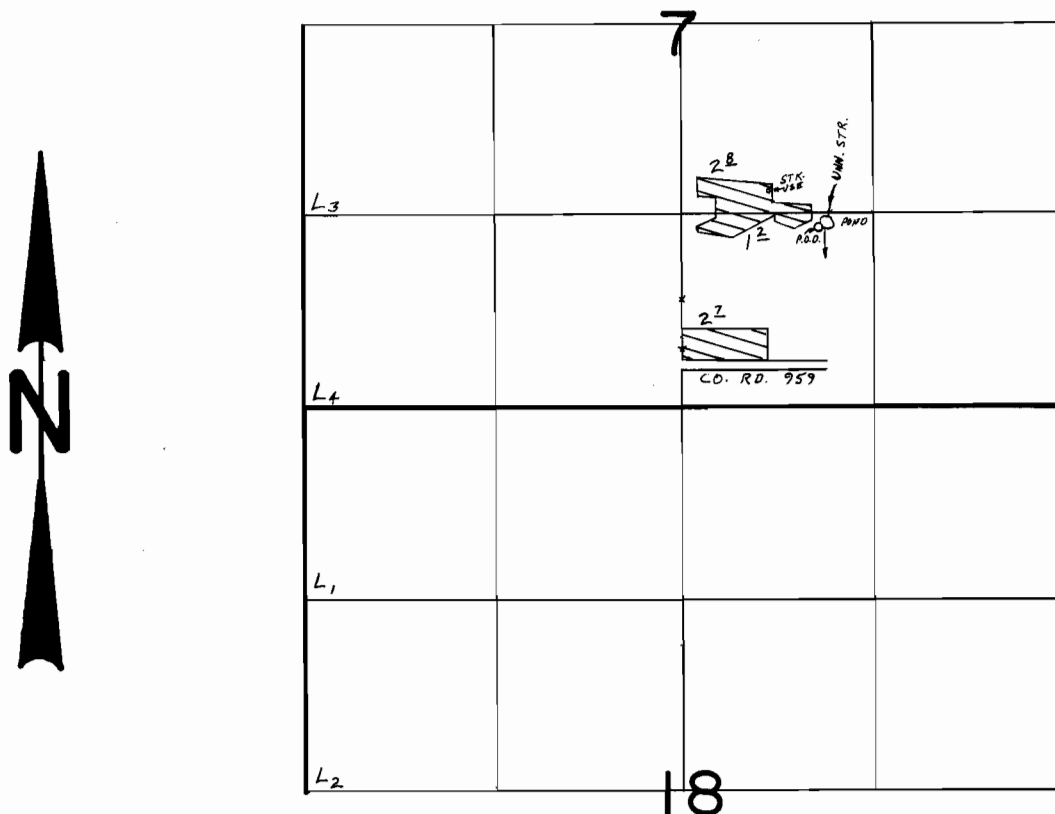

P.O.D. Loc. : 1210' N. & 950' E. from S 1/4 Cor. Sec. 7

Scale: 1" = 1320'

FINAL PROOF SURVEY

UNDER

Application No. 64610... Permit No. 47323.....
IN NAME OF

JOHN SHAFER

Surveyed May 8, 1986, by T. Warren