


T.4S. R.3W. W.M.

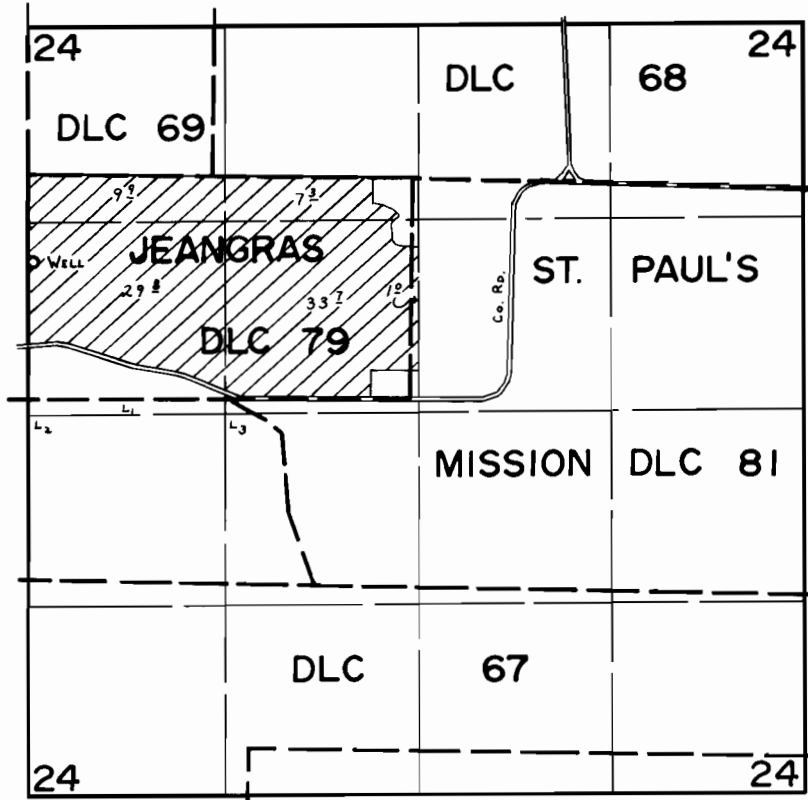

Div. Pt. Loc: 1060' N. & 30' E. fr. W. 1/4 Cor. Sec. 24.

FINAL PROOF SURVEY
UNDER

Application No. G-7930 Permit No. G-7317.....
IN NAME OF

HAROLD BRENTANO.....

Surveyed July 10, 1980, by C. L. Hughes.....