


T.4&5S. R.1W., W.M.

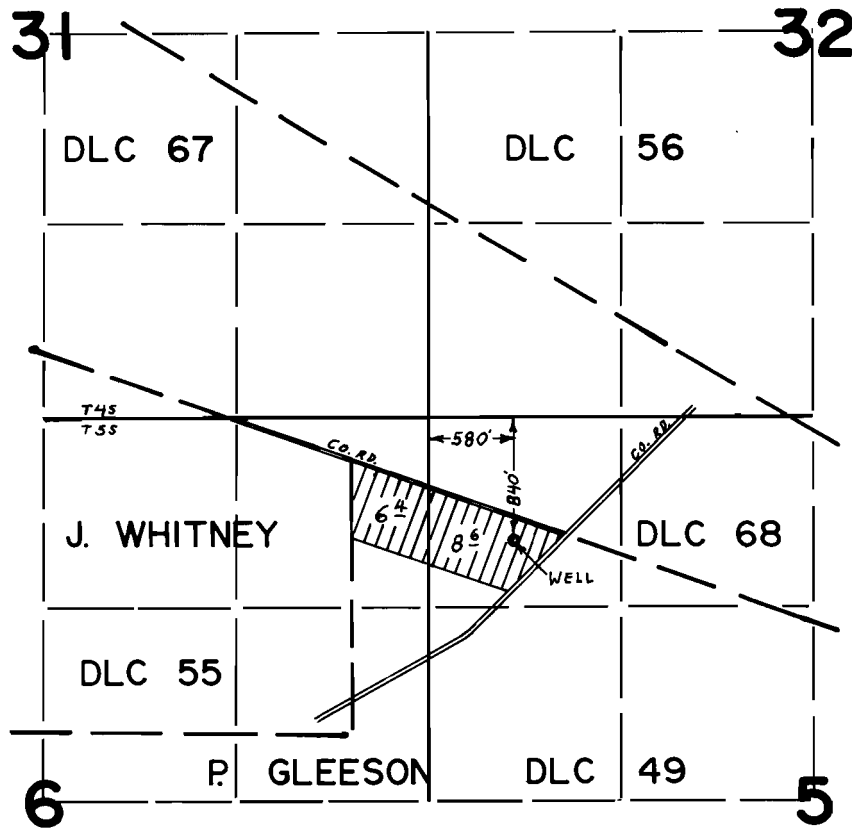

FINAL PROOF SURVEY UNDER

Application No. G-8707. Permit No. G-8079.
IN NAME OF

WILLIAM L. & JUDITH A. MILLER.

Surveyed JUNE 8, 1979, by L. H. NUNN