


T. 7S., R. 1W., W.M.

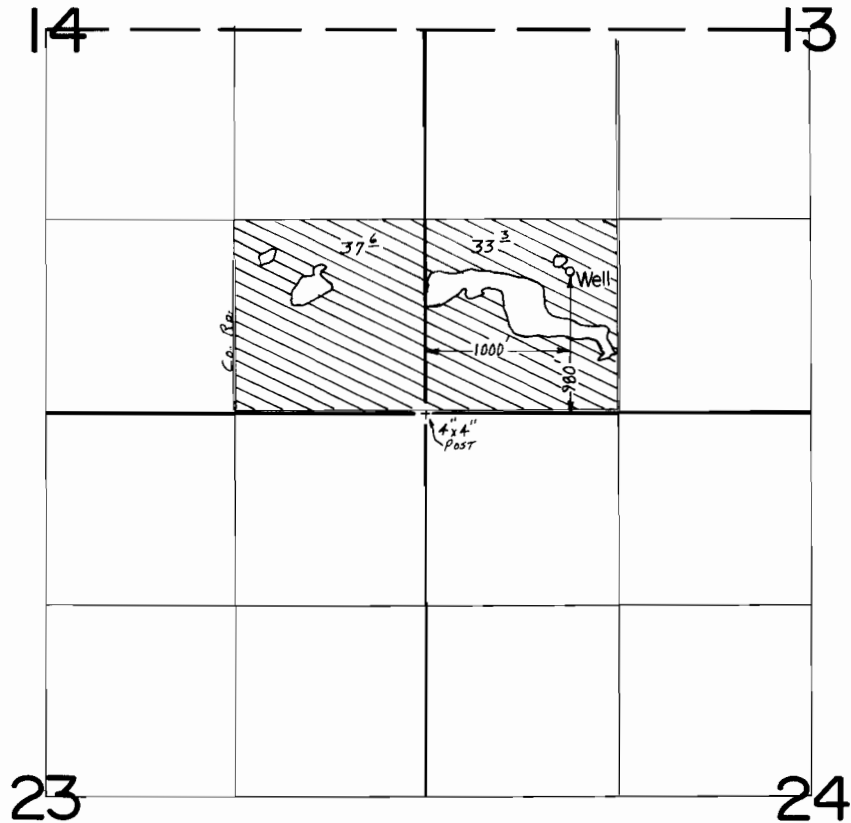

Scale: 1" = 1320'

FINAL PROOF SURVEY UNDER

Application No. G-8887.. Permit No. G-8282.....
IN NAME OF

NORMAN J. QUEEN

Surveyed May 28, 1985., by T. Warren.....