


T. 8S., R. 2W., W.M.

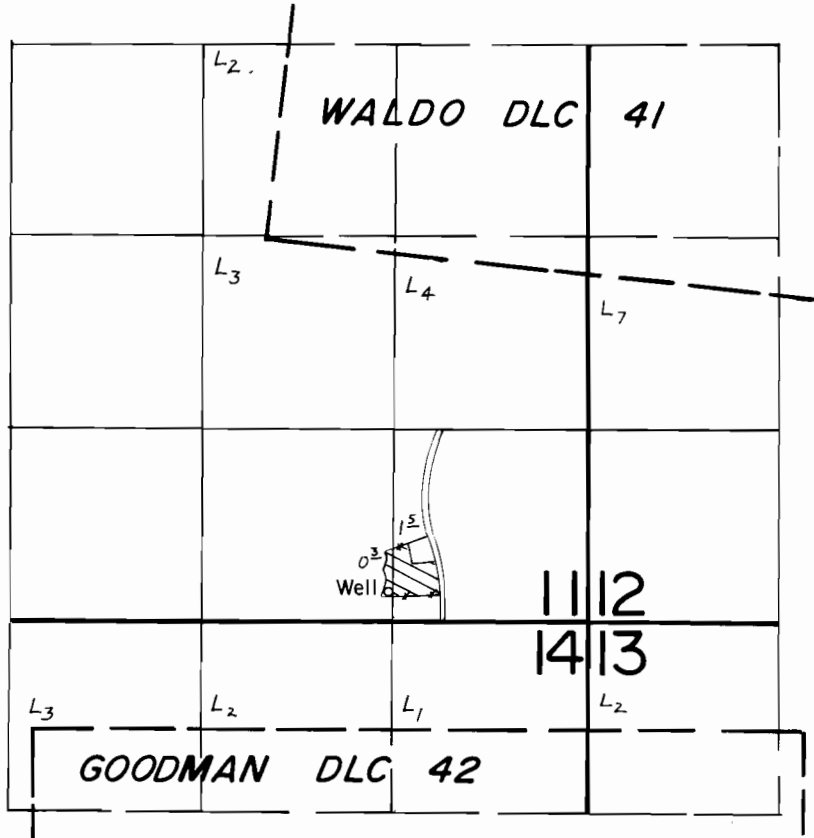

Well Loc. : 200' N. & 1360' W. from SE Cor. Sec. 11.

Scale: 1" = 1320'

**FINAL PROOF SURVEY**  
UNDER

Application No. G-11391... Permit No. G-10501....

IN NAME OF

**GARY L. EATHERLY**

Surveyed April 28, 1986., by T. Warren.....