G-6416
55839
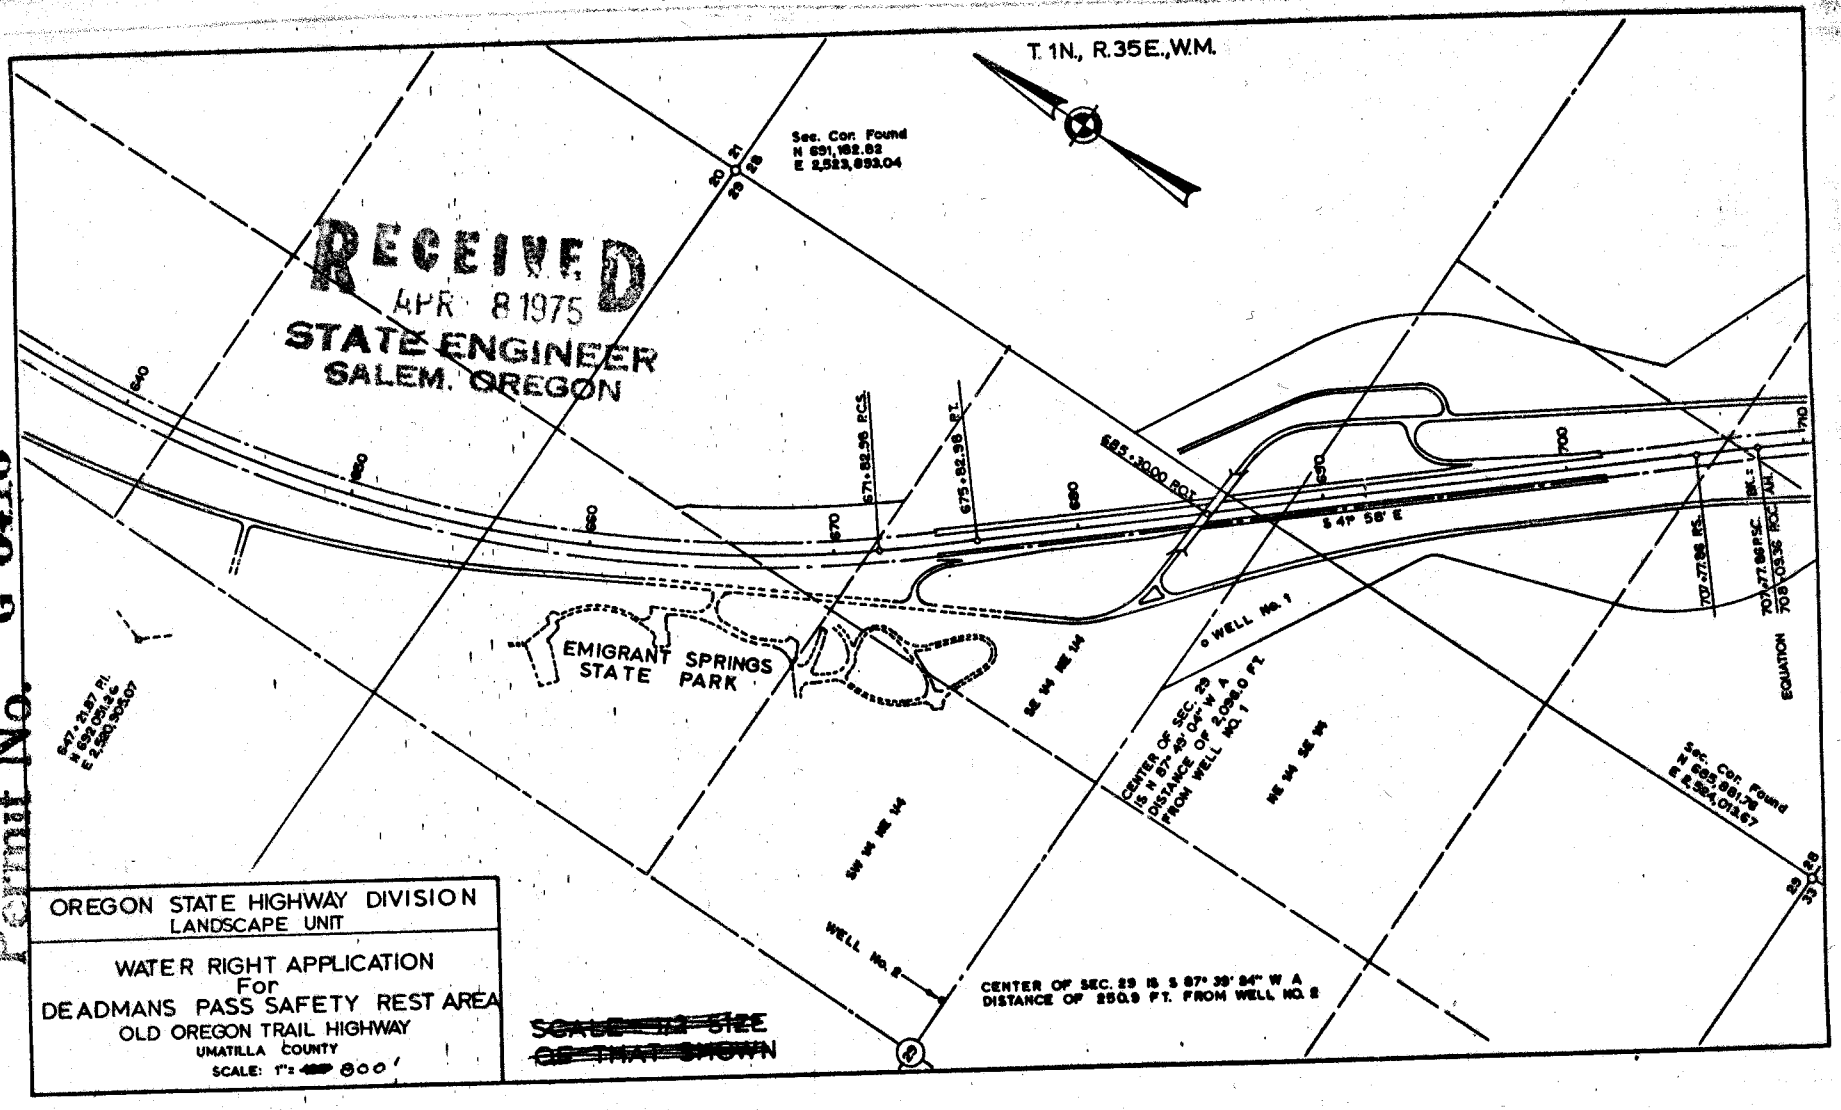
Application No. G-6885
Permit No. G 6416