


G 10258
55843

T. 4N., R. 29E., W. M.

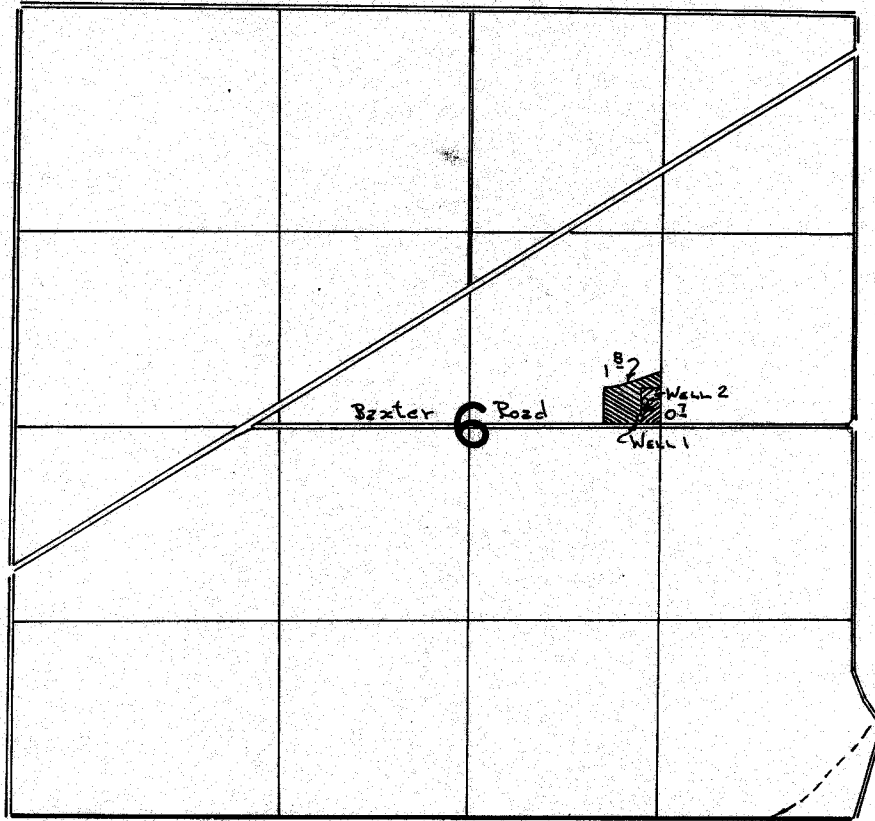

WELL 1 Loc: 60' N. & 1190' E. FROM CENTER COR. SECTION 6
WELL 2 Loc: 170' N. & 1210' E. FROM CENTER COR. SECTION 6

SCALE 4" = 1 MILE

FINAL PROOF SURVEY
UNDER

Application No. G:11128... Permit No. G:10258.
IN NAME OF

.....**WALTER E. KLIPPSTEIN**.....

Surveyed ...3..30..... 19.84., by V.L. Church.....